


Well Completion Diagram

API Well No: 05-063-06318-00 06344-00			
Owner: RITCHIE MUD DRILLING COMPANY INC		Well Name: 348'1	
County: KIT CARSON	Field: WILDCAT	Pool:	348'1
Coordinates: X	:Y	Sec: 34	Twp: 10S - 46W

Note: Changes to the drawing do not effect the database

PRIOR to
PLUGGING

Bore Diameters (in.)

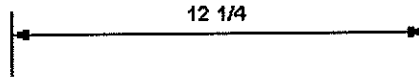


Cement Top: 0' mthd: U

8 5/8" SURF

440'

w/ 2855' TO SURFACE

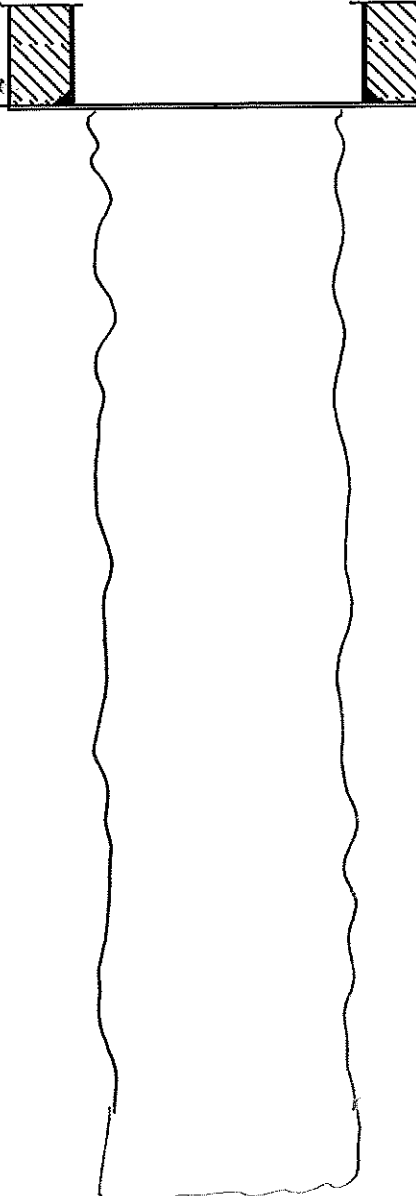

7 7/8" HOLE TO 5954'