

Well Completion Diagram

API Well No: 05-063-0631800 06345-00			
Owner: Ritchie	Well: SRINE COMPANY Gplauto, Inc	Well Name: SRINE CHAPIN-	Gay #1
County: KIT CARSON	Field: WILDCAT	Pool:	
Coordinates: X	Y	Sec: 23	Twp: 10S

Note: Changes to the drawing do not effect the database

- 96 w

Prior to
Plugging

Bore Diameters (in.)


12 1/4

Cement Top: 0' mthd: U

8 5/8" SURF

391' w/ 2855 ft

TO SURFACE

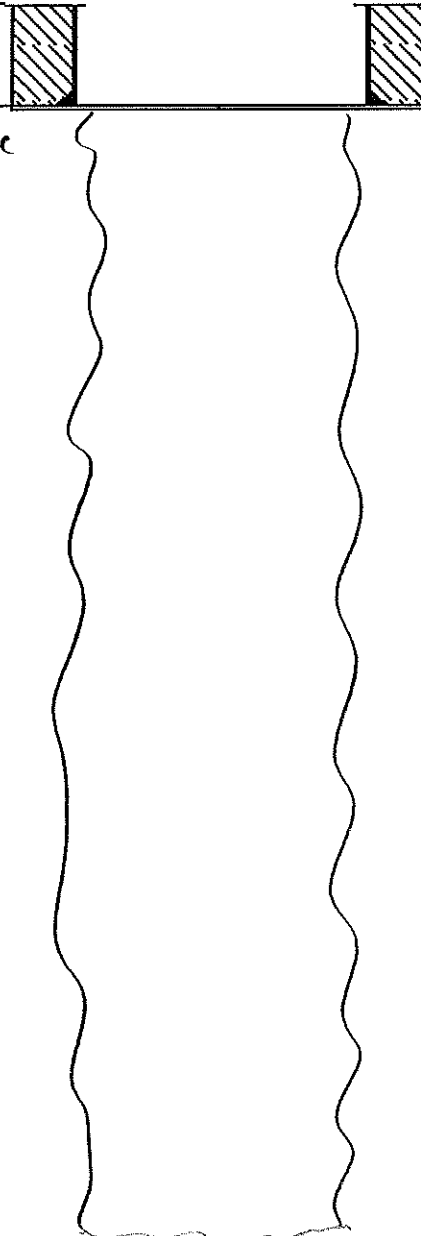

77/8" Hole to ~ 5950'