

Well Completion Diagram

API Well No: 05-063-0631800 06395-00			
Owner: Ritchie MULTI-DRILLING COMPANY INC Exploration Inc	Well Name: ADKATONE CHAPIN - 044-1		
County: KIT CARSON	Field: WILDCAT	Pool:	
Coordinates: X	Y	Sec: 23	Twp: 10S


Note: Changes to the drawing do not effect the database

-46w

Proposed
plugging

Bore Diameters (in.)

12 1/4

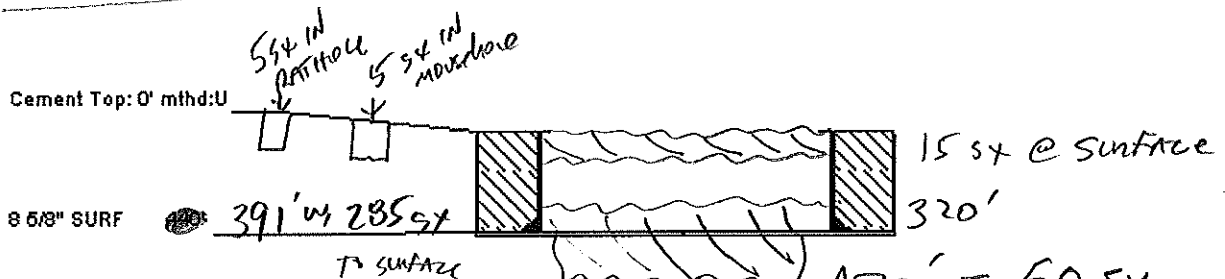

ANHYDRATE 3706'

3742'

DST - 5643'

5717'

2230'

2350' - 40 SY

2980'

3100' - 40 SY

5610

5730 - 40 SY

7 7/8 HOLE - 5950'