




Lat40°, Inc. 1635 Foxtrail Drive, Suite 325 Loveland, CO 970-776-3321

MULTI-WELL PLAN

ANTELOPE 41-31 PAD

THIS MAP DOES NOT REPRESENT A BOUNDARY SURVEY

SECTION: 31
TOWNSHIP: 5N
RANGE: 62W

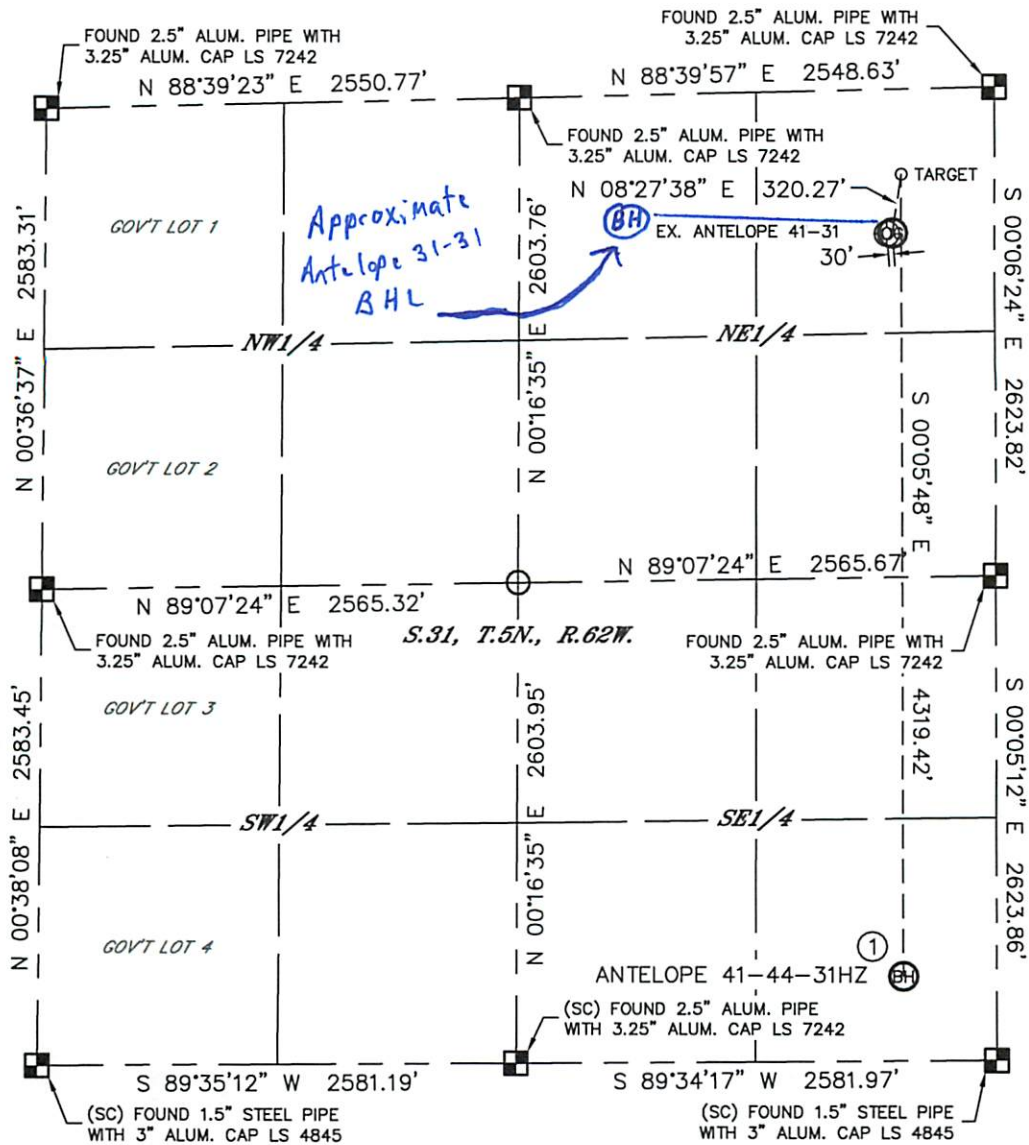

①


—BOTTOM HOLE—
ANTELOPE 41-44-31HZ
460' FSL
500' FEL
LAT: 40.35029°N
LONG: 104.35890°W

ⓑ

Antelope 31-31 BHL
667' FNL, 1982' FEL

LEGEND

- = ALIQUOT MONUMENT AS DESCRIBED
- = CALCULATED POSITION

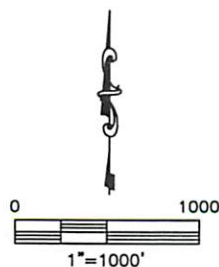



DATE: 8/10/2012
PROJECT#: 2011350



Lat40°, Inc. 1635 Foxtrail Drive, Suite 325 Loveland, CO 970-776-3321

MULTI-WELL PLAN
ANTELOPE 41-31 PAD

SECTION: 31
TOWNSHIP: 5N
RANGE: 62W

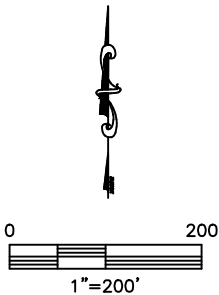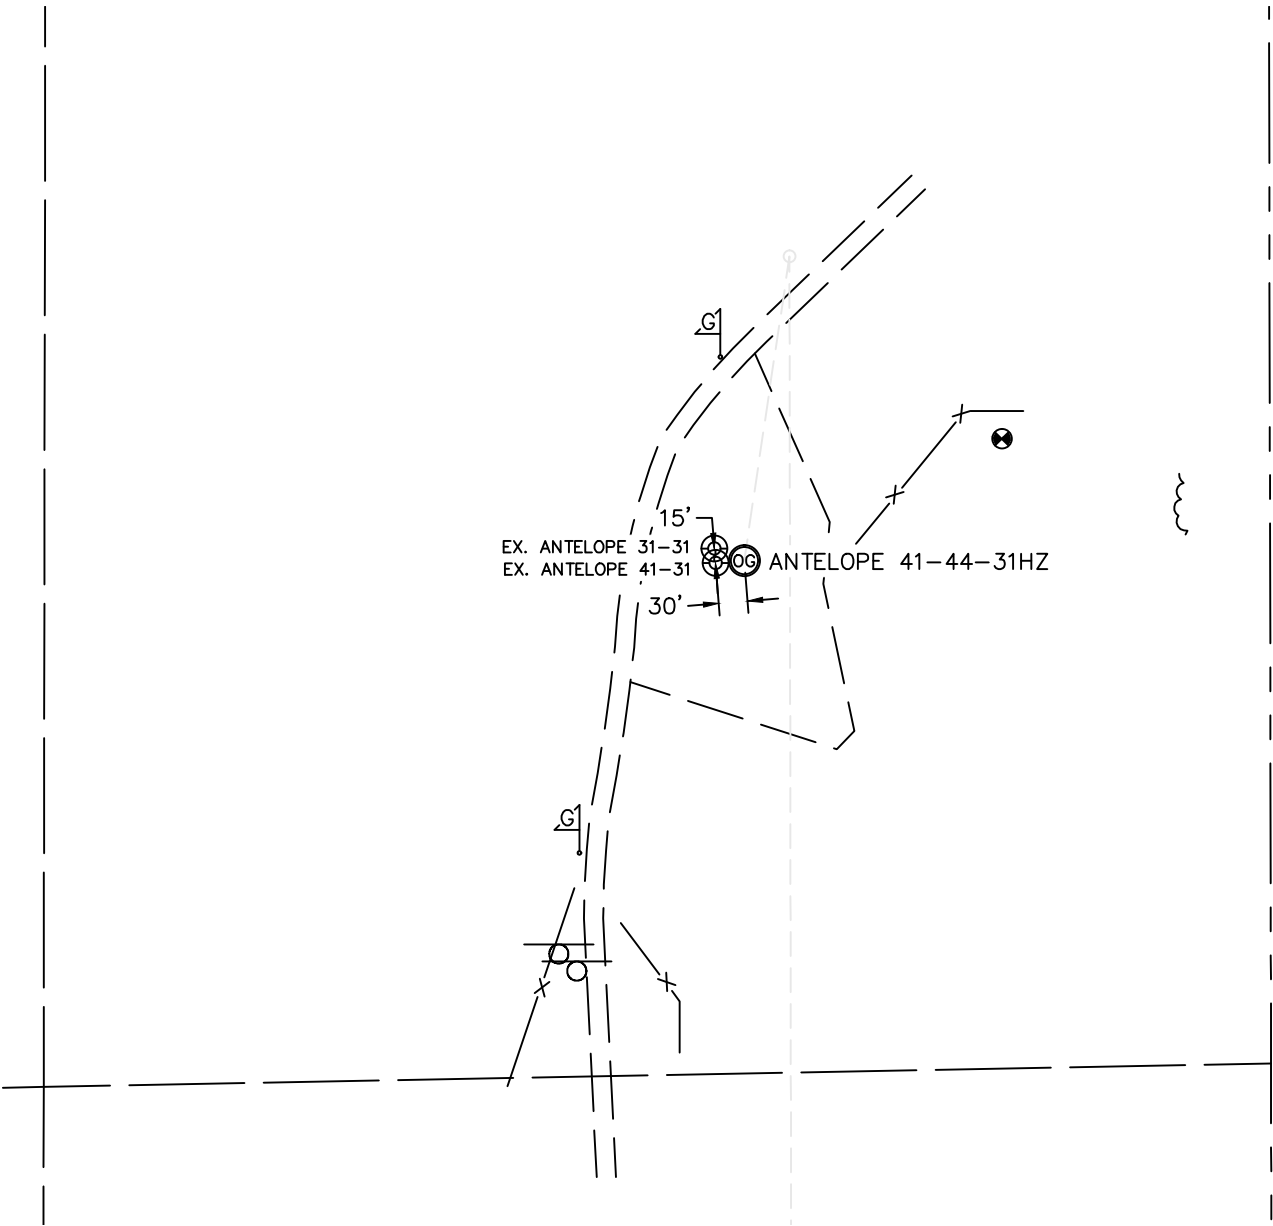

DATE: 8/10/2012
PROJECT#: 2011350