




Petroleum Development Corporation  
 Skurich SLW 7D  
 Sec 7 T5N R63W  
 Weld County, CO

Current Wellbore Schematice - NOT TO SCALE!!!

3/1/2011

API#: 05-123-20499

GL Elevation: 4640

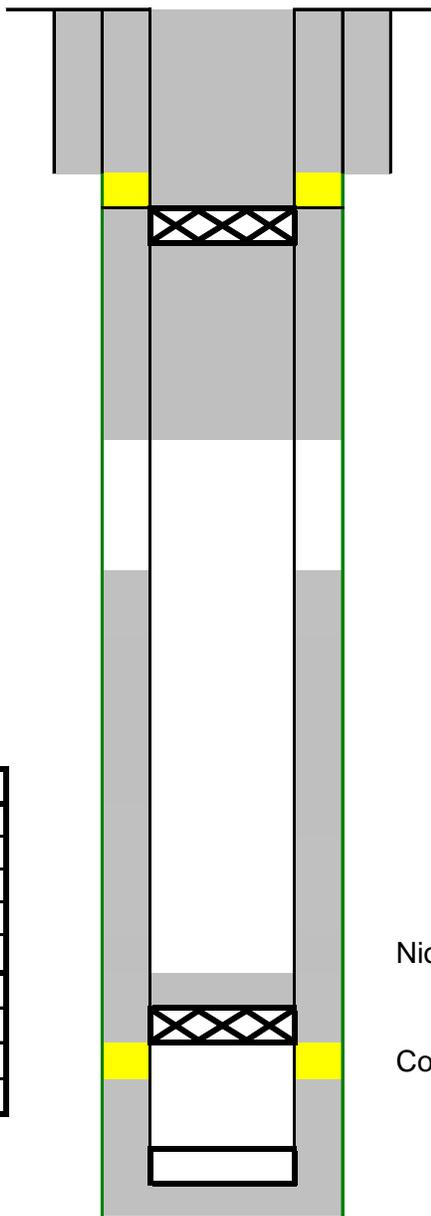

Surface Casing:
8 5/8" @ 372' 275sx cmt.

Squeeze perf @ 750'
CIBP @ 760'

Production Casing:
41/2" @ 6963' w/ 446 sks

Top of Cement:
0' & 2950'

Perforations:	
Old:	Codell:6714'-6722'
	0
	0
	0
New:	Squeeze perf @ 750'
	0
	0
	0

Niobrara

Codell

PBTD:	6963
Casing TD:	6963

NOTES

TIH w/ CIBP, set @ 6664, dump bail 2 sx cmt. POOH to 750', shoot 2 holes, sqz w/ 400 sx 15.8# 1.15Y "G", no returns, assume cement balanced through casing leak below squeeze perf, circ up annulus. Set CIBP @ 760', sqz w/ 450 sx 15.8# 1.15Y "G", return 12 bbl to tank

