

WPX Energy Rocky Mountain LLC

FINAL

RWF 343-31


API #05-045-19788-00

367' FSL x 2412' FWL - (SESW) - SHL

2087' FSL x 721' FEL - (NESE) - BHL

Section 31-T6S-R94W

Garfield County, Colorado

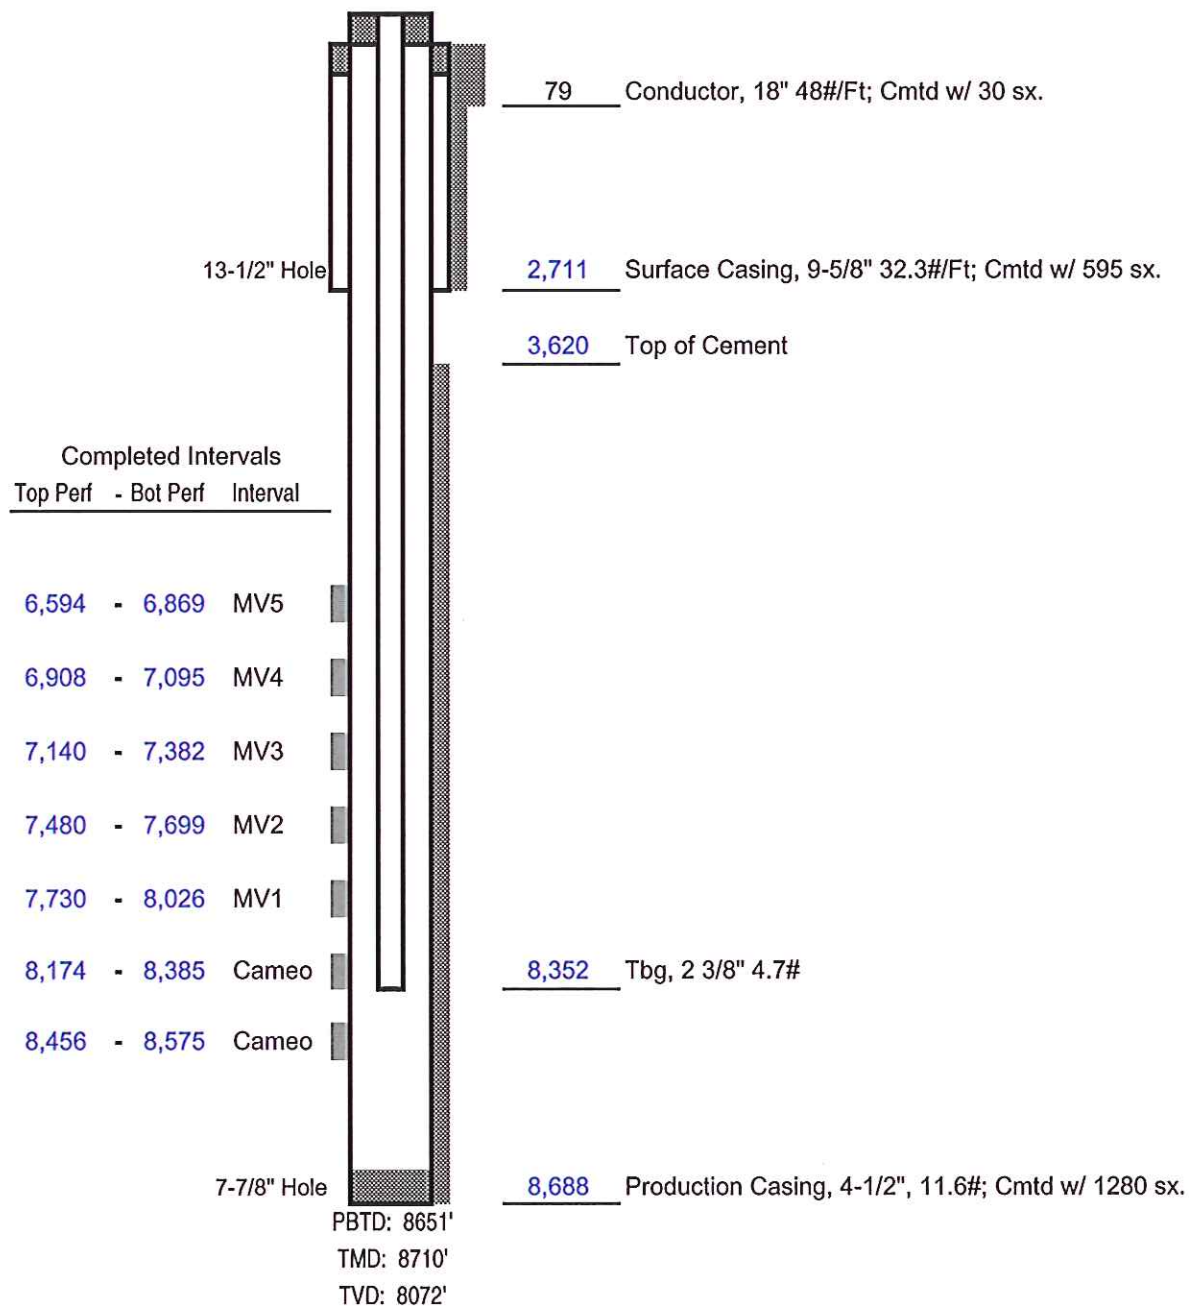

Not to Scale