

WPX Energy Rocky Mountain LLC

FINAL

RWF 21-36


API #05-045-20752-00

1555' FNL x 1760' FWL - (SEnw) - SHL

797' FNL x 2295' FWL - (NENw) - BHL

Section 36-T6S-R94W

Garfield County, Colorado

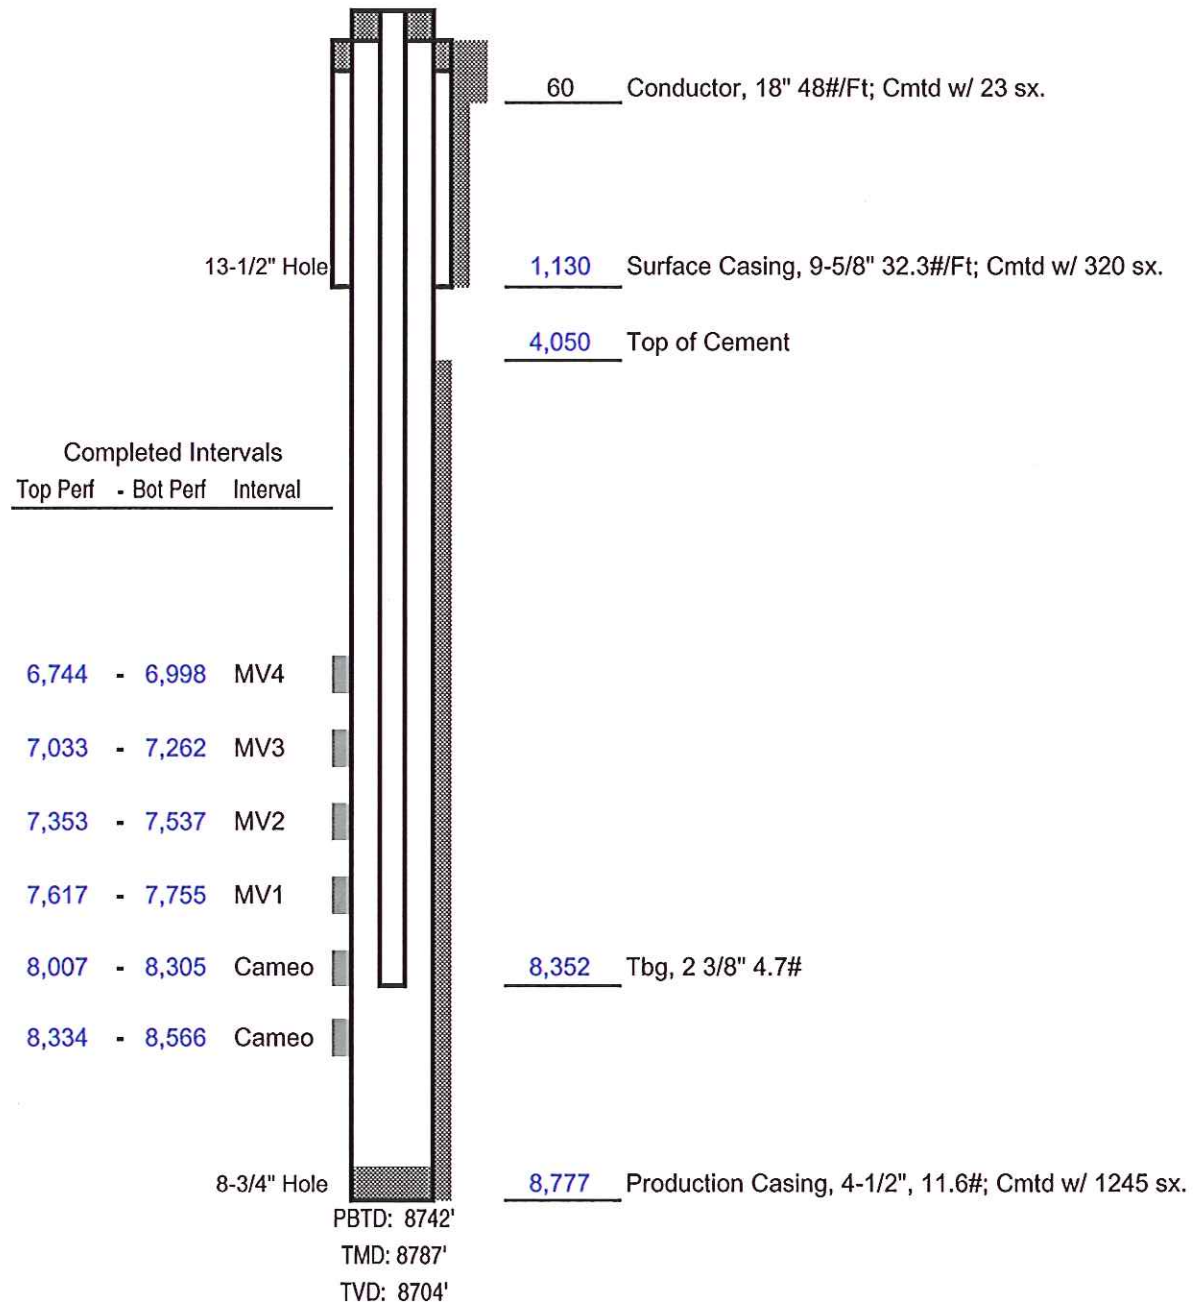

Not to Scale