


WPX Energy Rocky Mountain LLC
RWF 321-32
 API #05-045-21061-00
 1074' FNL x 1359' FWL - SHL
 166' FNL x 2089' FWL - BHL
 (NENW) Section 32-T6S-R94W
 Garfield County, Colorado

FINAL

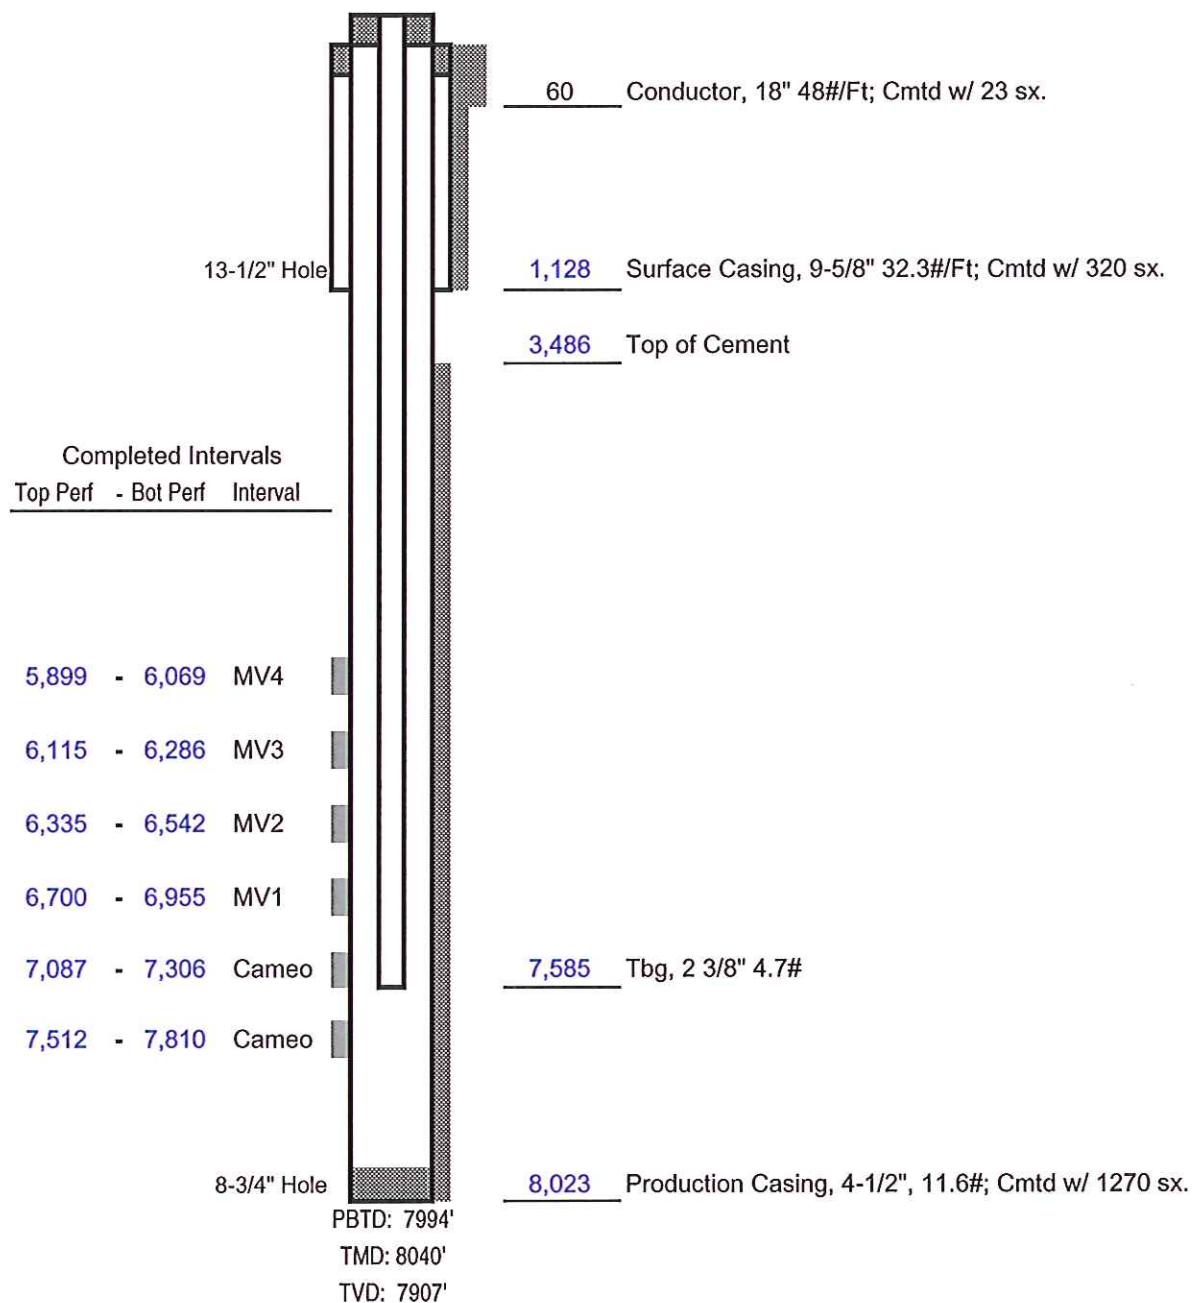

Not to Scale