




Lease Name: Aims #33-10D

Legals: NESE – Sec. 10, T5N, R66W

County: Weld County, Colorado

API#: 05-123-34662

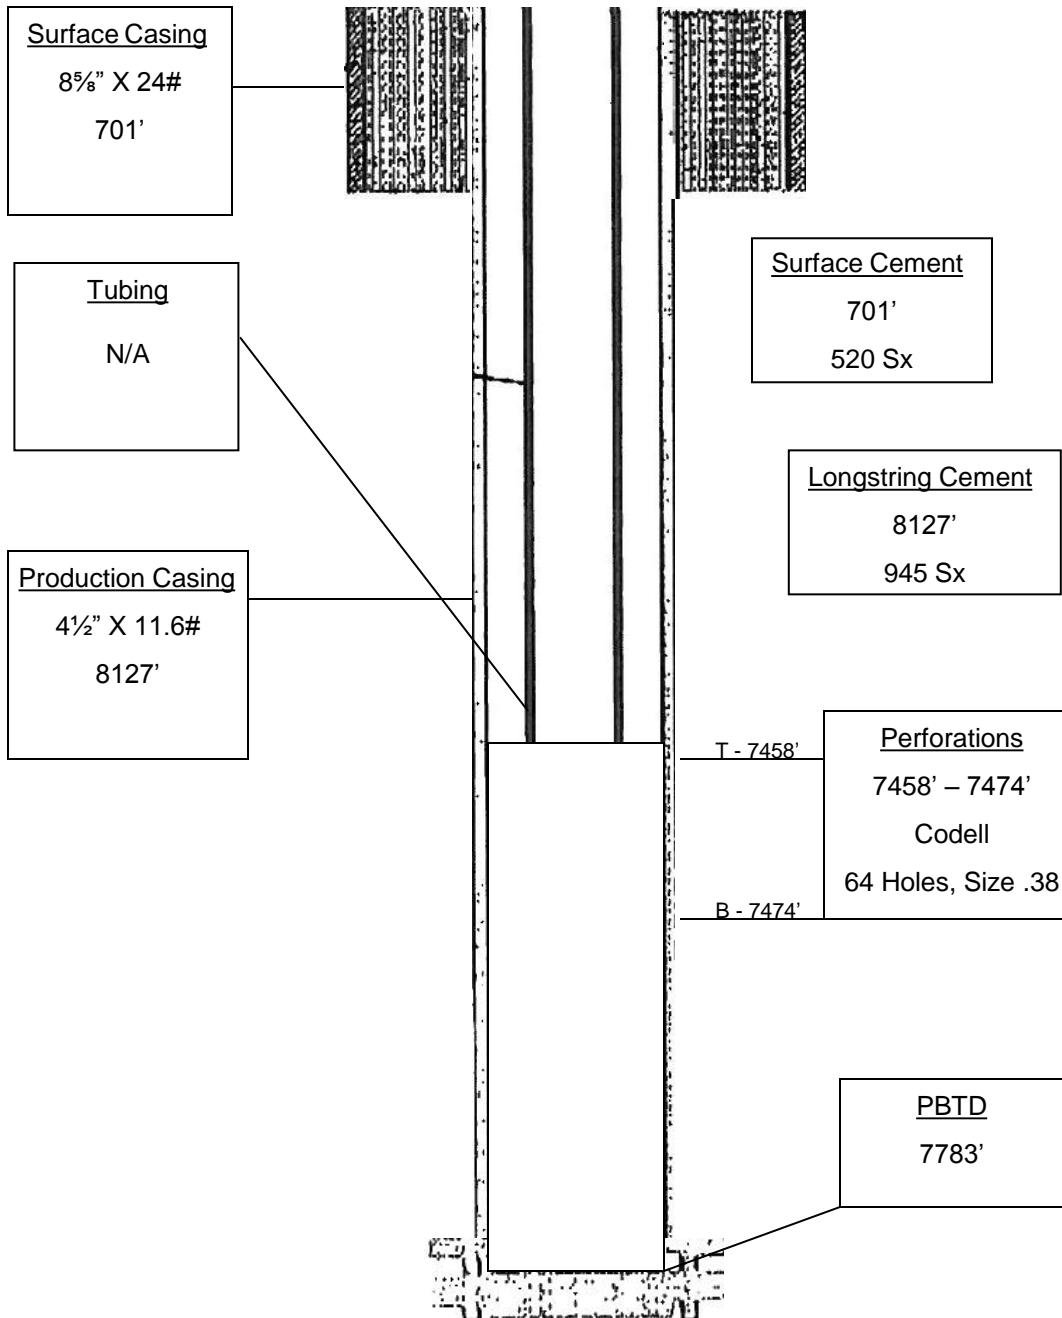

Wellbore Diagram