




**Lease Name:** GCC 12-11D

**Legals:** NESE – Sec. 10, T5N, R66W

**County:** Weld County, Colorado

**API#:** 05-123-34543

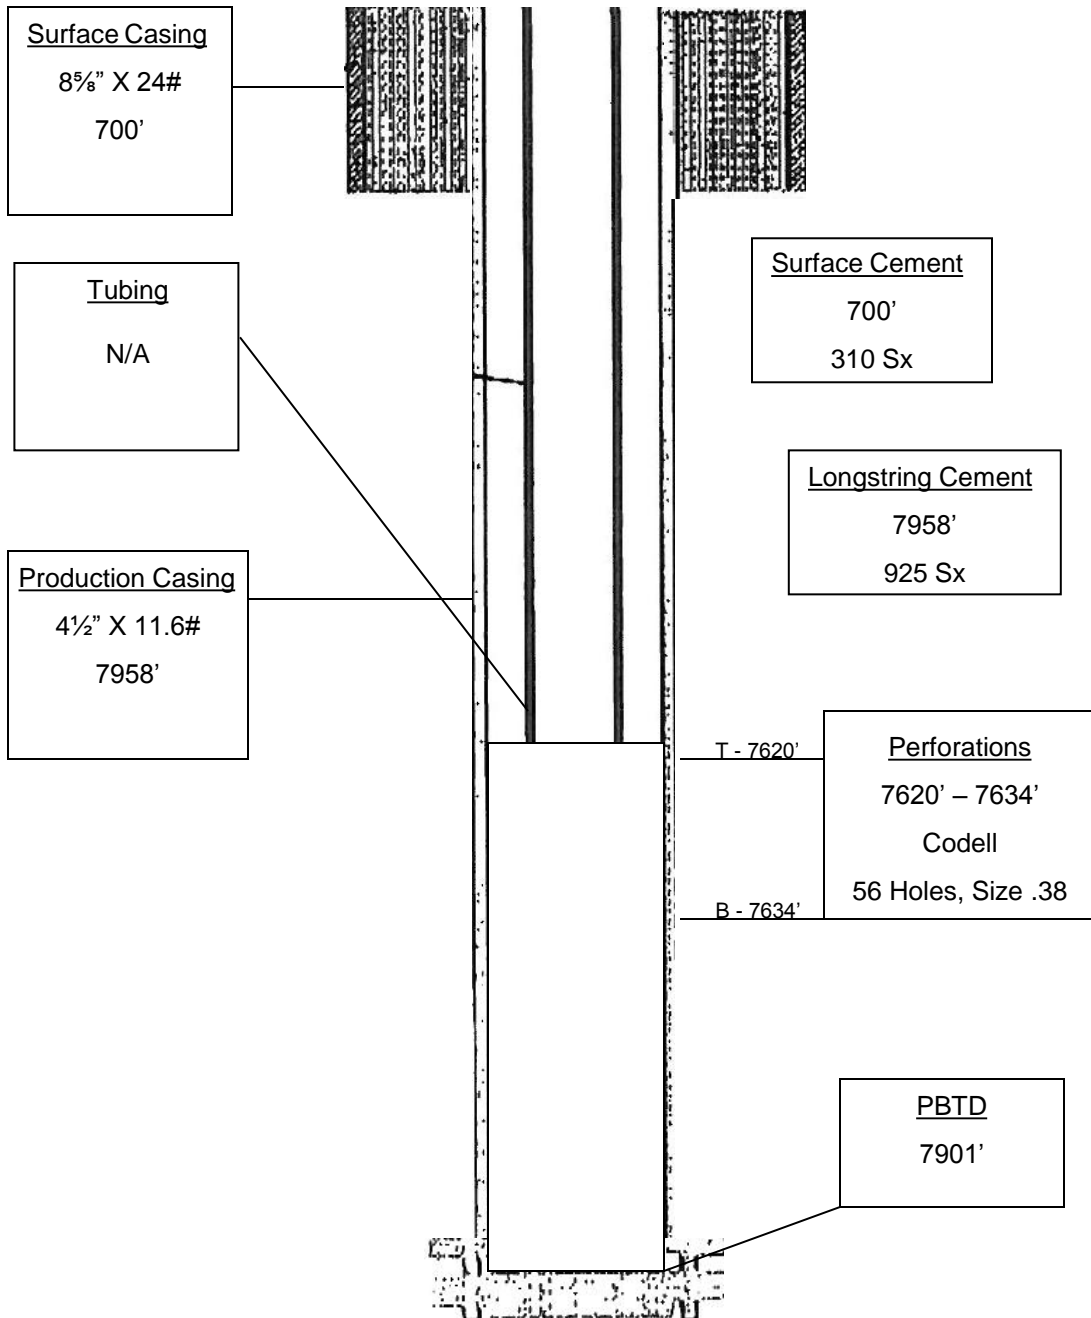

**Wellbore Diagram**