

OXY USA INC.


Downhole Schematic

Well Name: Rowe A-1 API: 05-011-06100

DATE: 09/03/2012 AUTHOR: D.Berg/K. Andrews

LOCATION: 990' FNL & 990' FEL of Section 25 Township 21S Range 48W, Bent Co., Colorado

GL: 3801'
KB: ?'

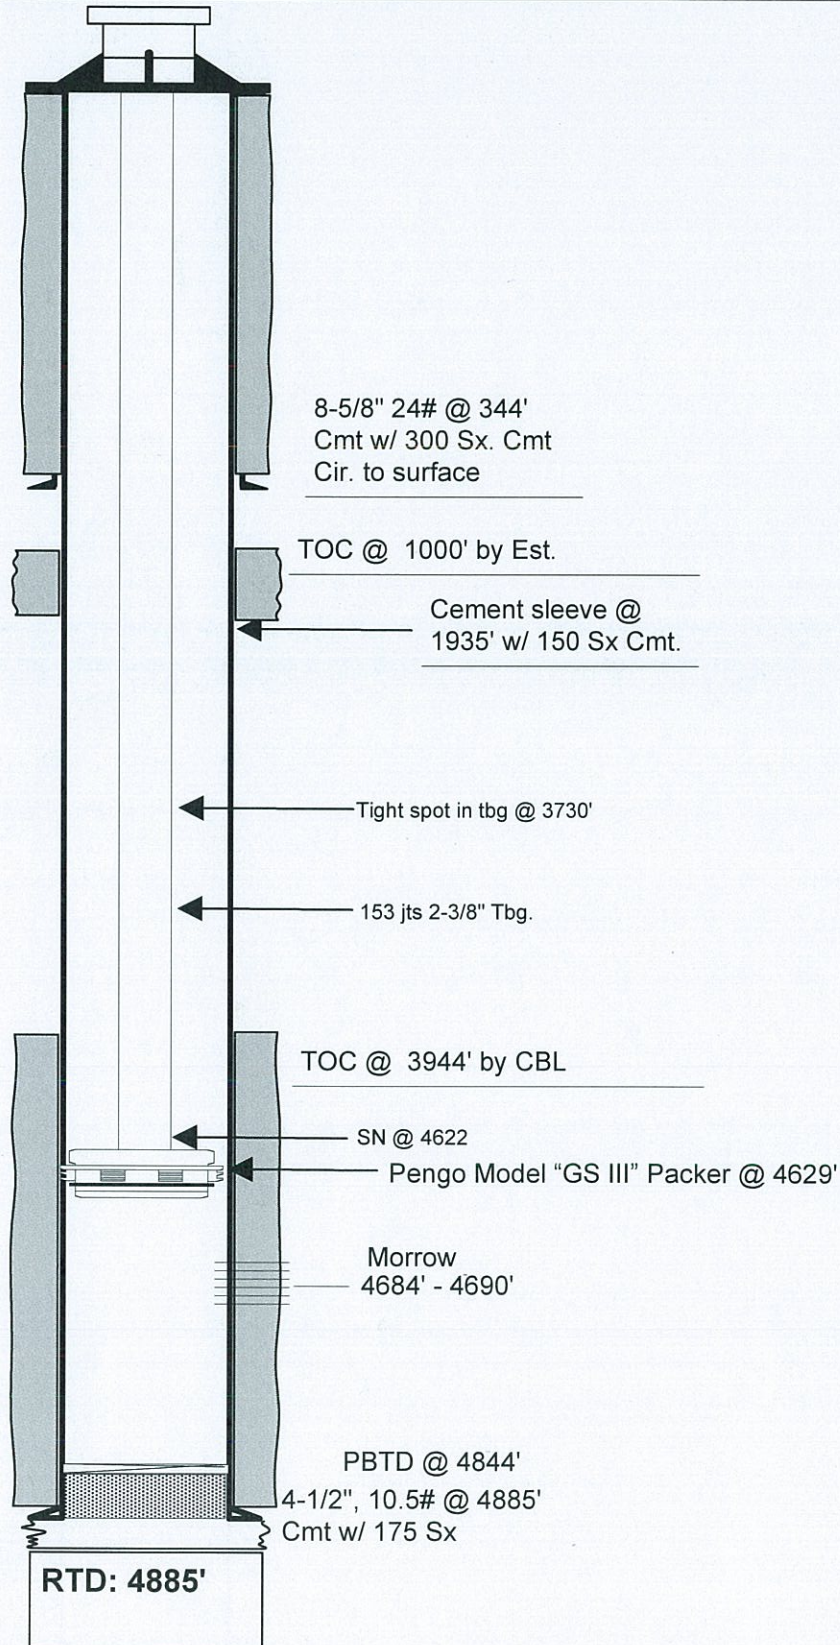

Notes:

Stone Corral: 1868'.

Cherokee 4045'.

Atoka 4326'.

Morrow 4538'.

M-1 Sandstone 4680'

Suspect hole in tbg @ unknown
depth. Suspect hole in csg @
unknown depth. Also suspect
collapsed tbg.

CURRENT COMPLETION