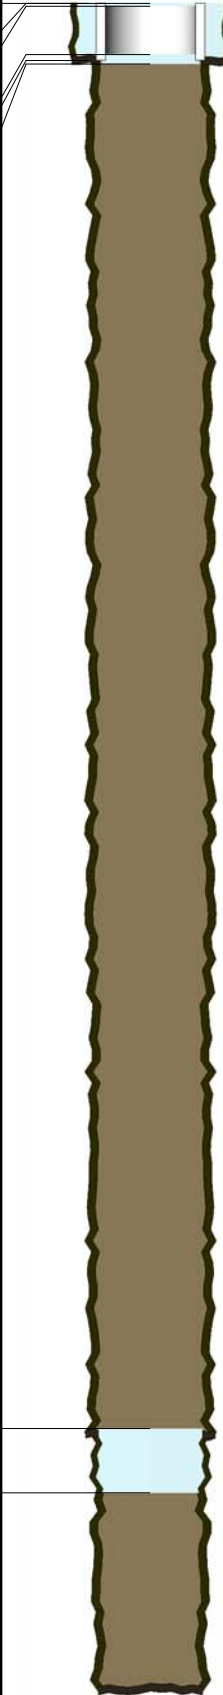


W

Casing Information	Casing Size & Weight	Cement Fluid (sacks)	Cement Depths (ft)	Schematic (9/4/2012)	Hole Size (in)	MD / PBMD (usft)	Perforation Intervals
SURFACE CASING - Set @ 312.0usft	9.625in, 32.30ppf	, UNKNOWN W/ 6% GEL, 170	10 (TOC) 10 (TOC) 25 280 (TOC) 312 330				
		, COMMON, SLO-SET, 100 20 , COMMON, 5	7550 (TOC) 7890			MD: 8,938 PBMD:	