




Lat40°, Inc. 1635 Foxtrail Drive, Suite 325 Loveland, CO 970-776-3321

## MULTI-WELL PLAN

ANTELOPE J-19 PAD

THIS MAP DOES NOT REPRESENT A BOUNDARY SURVEY

SECTION: 19  
TOWNSHIP: 5N  
RANGE: 62W

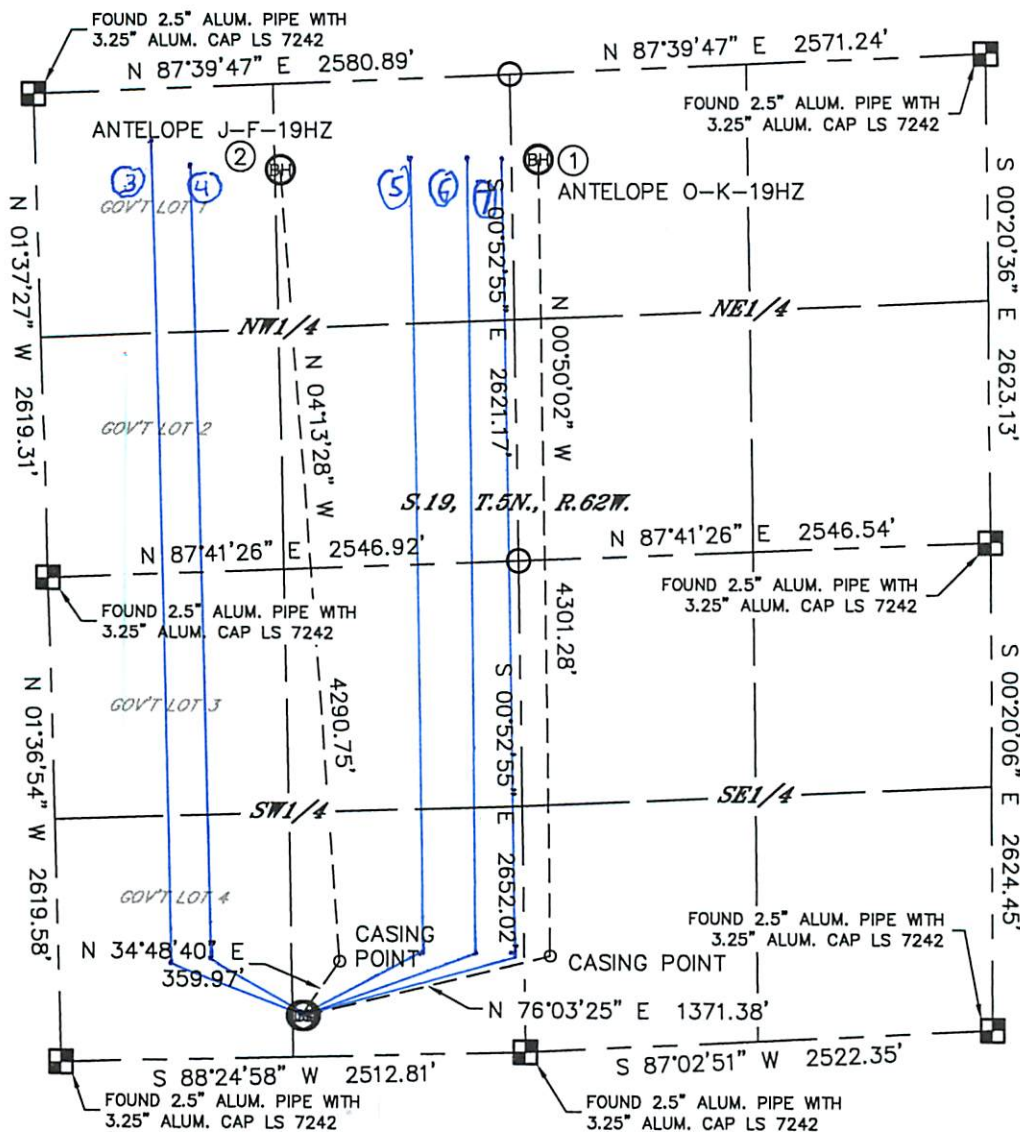

①  
-BOTTOM HOLE-  
ANTELOPE O-K-19HZ  
460' FNL  
2420' FEL  
LAT: 40.39078°N  
LONG: 104.36527°W

②  
-BOTTOM HOLE-  
ANTELOPE J-F-19HZ  
460' FNL  
1320' FNL  
LAT: 40.39067°N  
LONG: 104.37030°W

③  
460 FNL  
610 FNL

④  
460 FNL  
160 FNL


⑤  
460 FNL  
2160 FNL

⑥  
460 FNL  
231 FNL

⑦  
460 FNL  
2460 FNL

### LEGEND

- = ALIQUOT MONUMENT AS DESCRIBED
- = CALCULATED POSITION

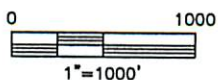

DATE: rev 8/8/2012  
PROJECT#: 2012071