


Walker 'O'

Petroleum Energy

John Julander

SWSE Sec 18 8N 57W

N

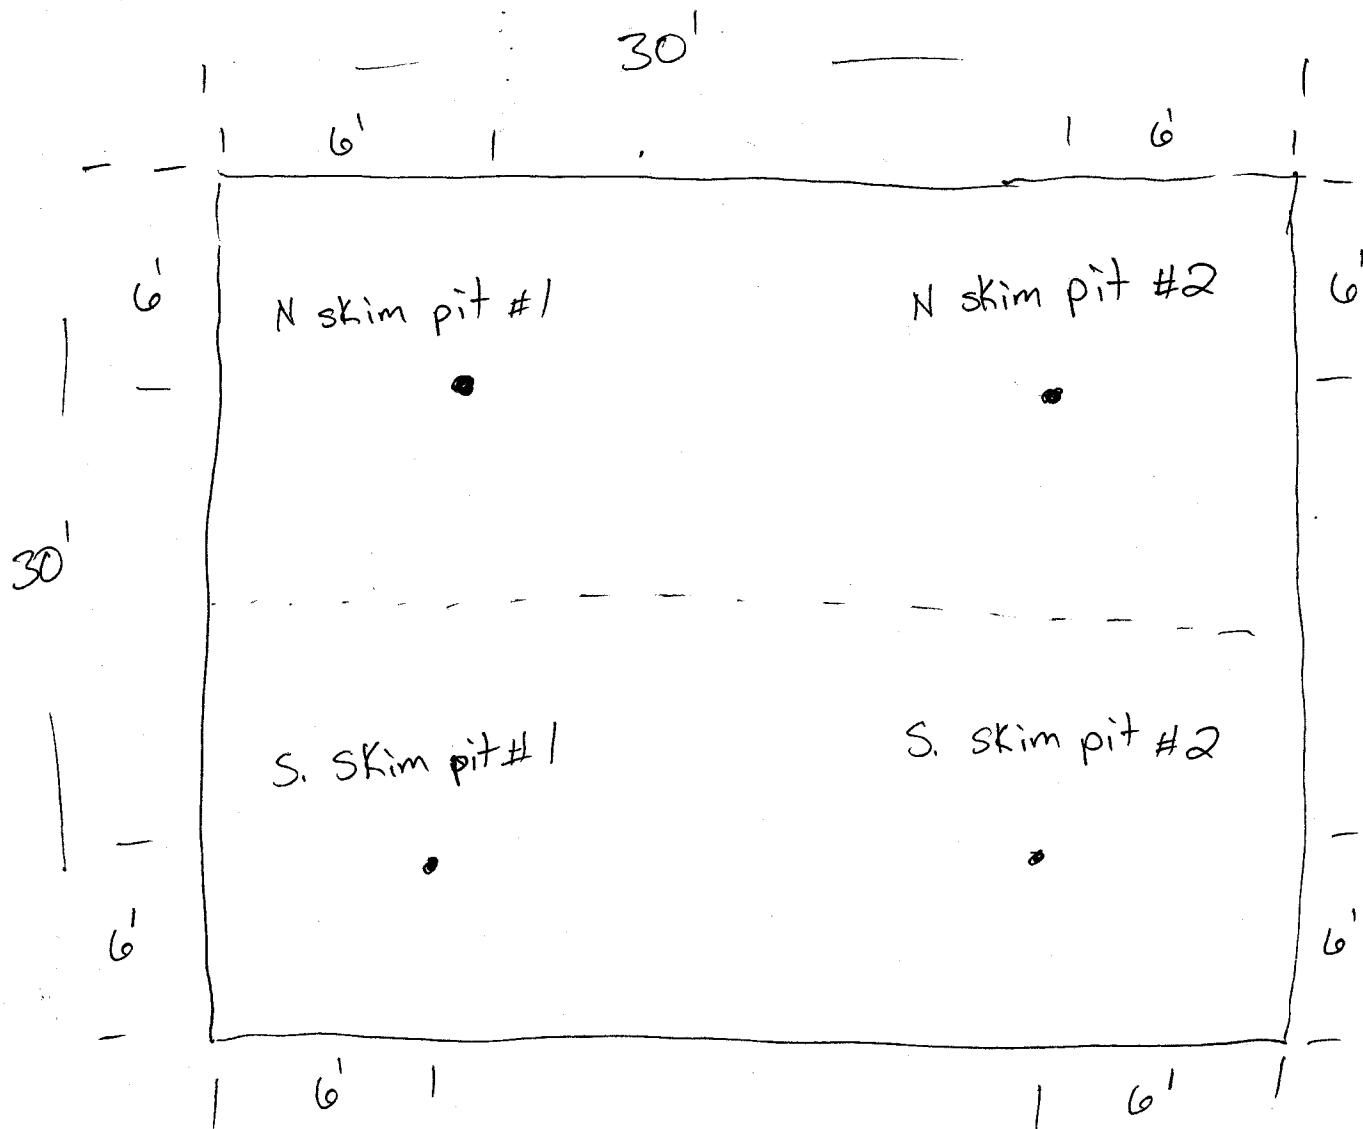

S

Note: All samples were taken at a depth of 10 feet.
Samples - Sludge Pit #1 and Sludge Pit #2 were taken from the pile that was excavated.