

WPX Energy Rocky Mountain Company, LLC

Jolley KP 43-21

Kokopelli Field


SHL 249' FNL 495' FEL (NE/4 NE/4) BHL 2493' FSL 530' FEL (NE/4 SE/4, Sec. 21, T6S, R91W)

Section 28-T6S-R91W 6th PM

Garfield County, Colorado

Formation Tops

(Measured Depths)

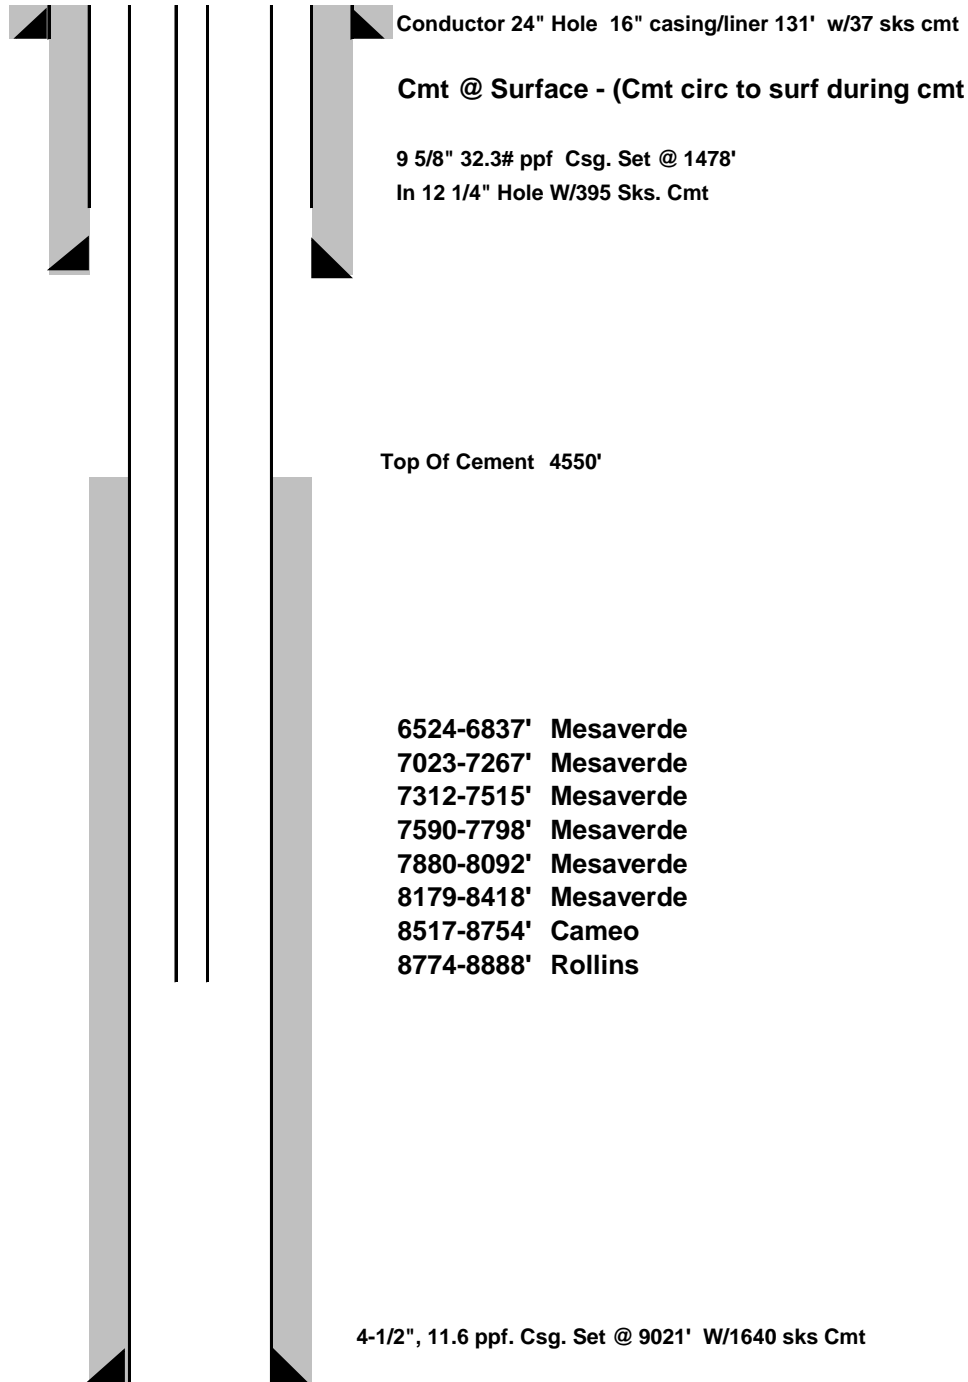

Tubing String: 2-3/8" Set @8177'

PBTD @ 8985'

TMD @ 9040'

TVD @ 8209'