


WELL LOCATION CERTIFICATE

THIS MAP DOES NOT REPRESENT A BOUNDARY SURVEY


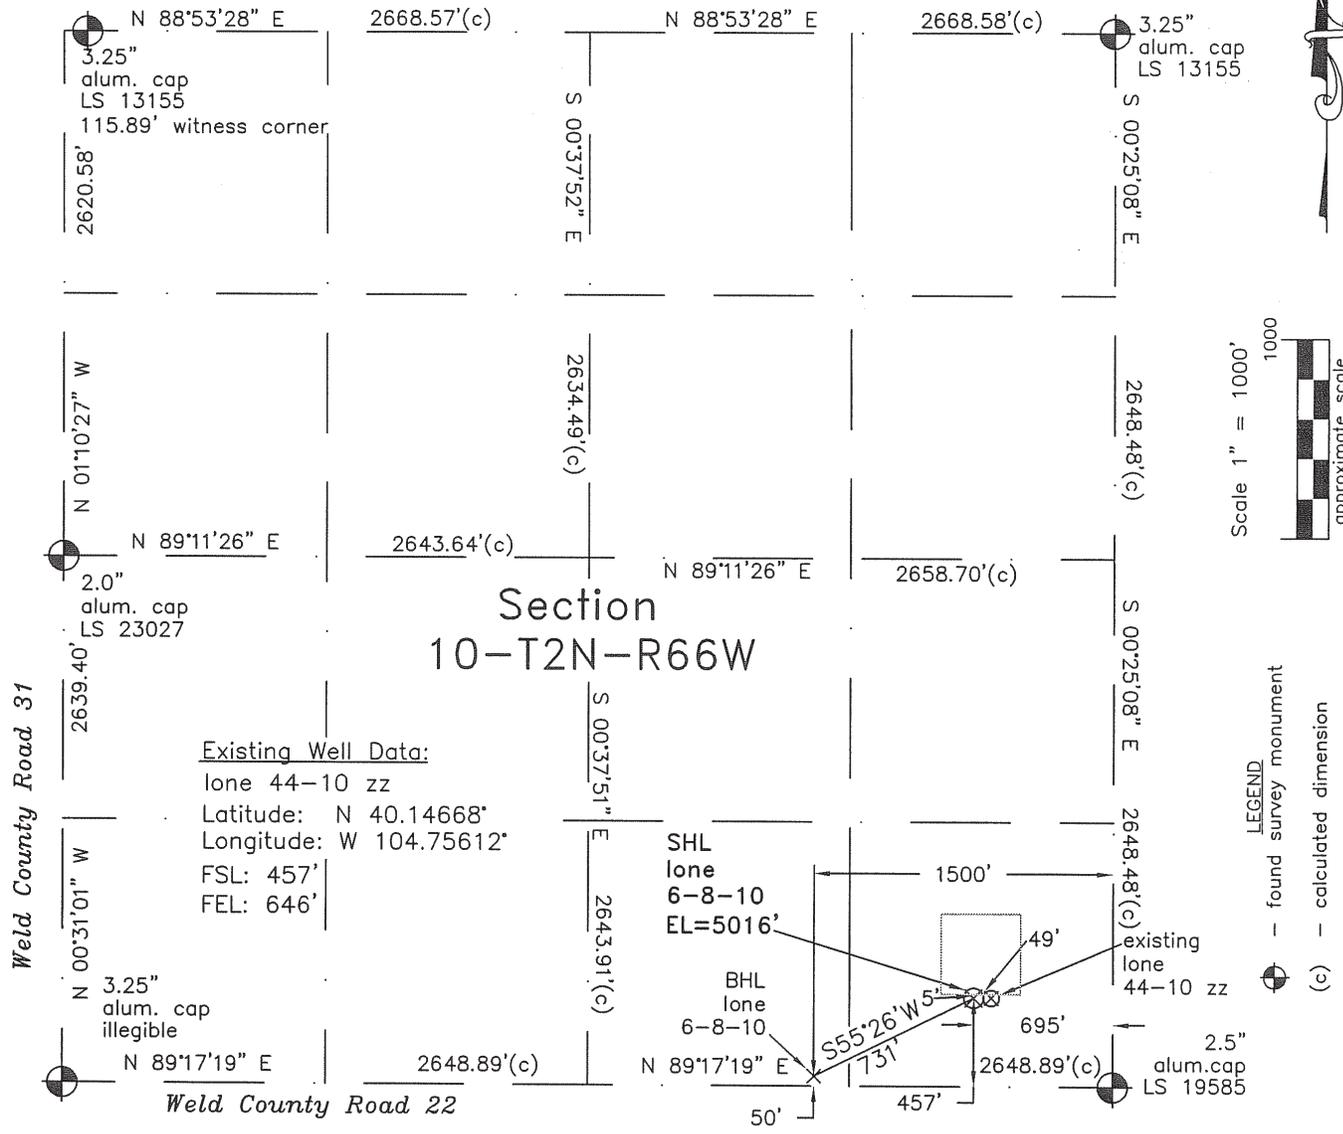


Existing Well Data:
 lone 44-10 zz
 Latitude: N 40.14668°
 Longitude: W 104.75612°
 FSL: 457'
 FEL: 646'

SHL
 lone
 6-8-10
 EL=5016'

BHL
 lone
 6-8-10

existing
 lone
 44-10 zz
 2.5\"/>

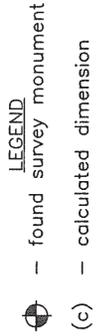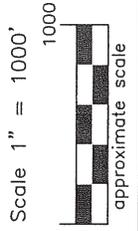

In accordance with a request from Dave Bale of EnCana Oil & Gas (USA) Inc., Frederick Land Surveying, Inc. has determined the location of the **lone 6-8-10** well site to be SHL: 457' FSL and 695' FEL, BHL (50' FSL and 1500' FEL) as measured at ninety (90) degrees from the section lines of Section 10, Township 2 North, Range 66 West, 6th Principal Meridian, Weld County, CO.

Proposed Surface Hole Data:

Latitude: N 40.14668° BHL(40.14556°)
 Longitude: W 104.75630° BHL(104.75846°)
 Nearest: Building 1593' southeast Above Ground Utility 4700' west
 Public Road 457' south Railroad 14,820' southwest
 Property Line 457' south
 PDOP: 2.3

I hereby certify that this Well Location Certificate was prepared by me or under my direct supervision on 2/13/10 for and on behalf of EnCana Oil & Gas (USA) Inc. and that it is a Land Survey plat and that it is not to be relied upon for establishment of fences, buildings, or other future improvement lines.

Alex Ronald Perkins #34176
 Job #: 09034.076 2-15-2010

- Notes:
- 1) Bearings and distances based on NAD 83 Colorado North State Plane Coordinates using RTK GPS observations taken 2/04/10 by operator Craig Burke.
 - 2) Conversion factor to ground (1.000275398).
 - 3) Elevations based on NAVD 88 GPS heights and Geoid 2003 corrections.
 - 4) See improvement map for visible improvements within 400 feet.
 - 5) The location falls on agricultural land (dryland pasture).

NOTICE: According to Colorado law you must commence any legal action based upon any defect in this W.L.C. within three years after you first discover such defect. In no event may any action based upon any defect in this W.L.C. be commenced more than ten years from this said date of the certification shown hereon.