

Downhole Schematic for SG WD08A-19 C19 495



Project :North Piceance

API #:05045211310000

Surface Location : NENW Sec 19 T4S - R95W 6th PM

Area : Story Gulch

County :


BHL : SENE-19-4S-95 W 6th PM

As Of : 09/12/2012

GL : 8122.0 ft

KB to GL : 30.6 ft

KB : 8152.6 ft

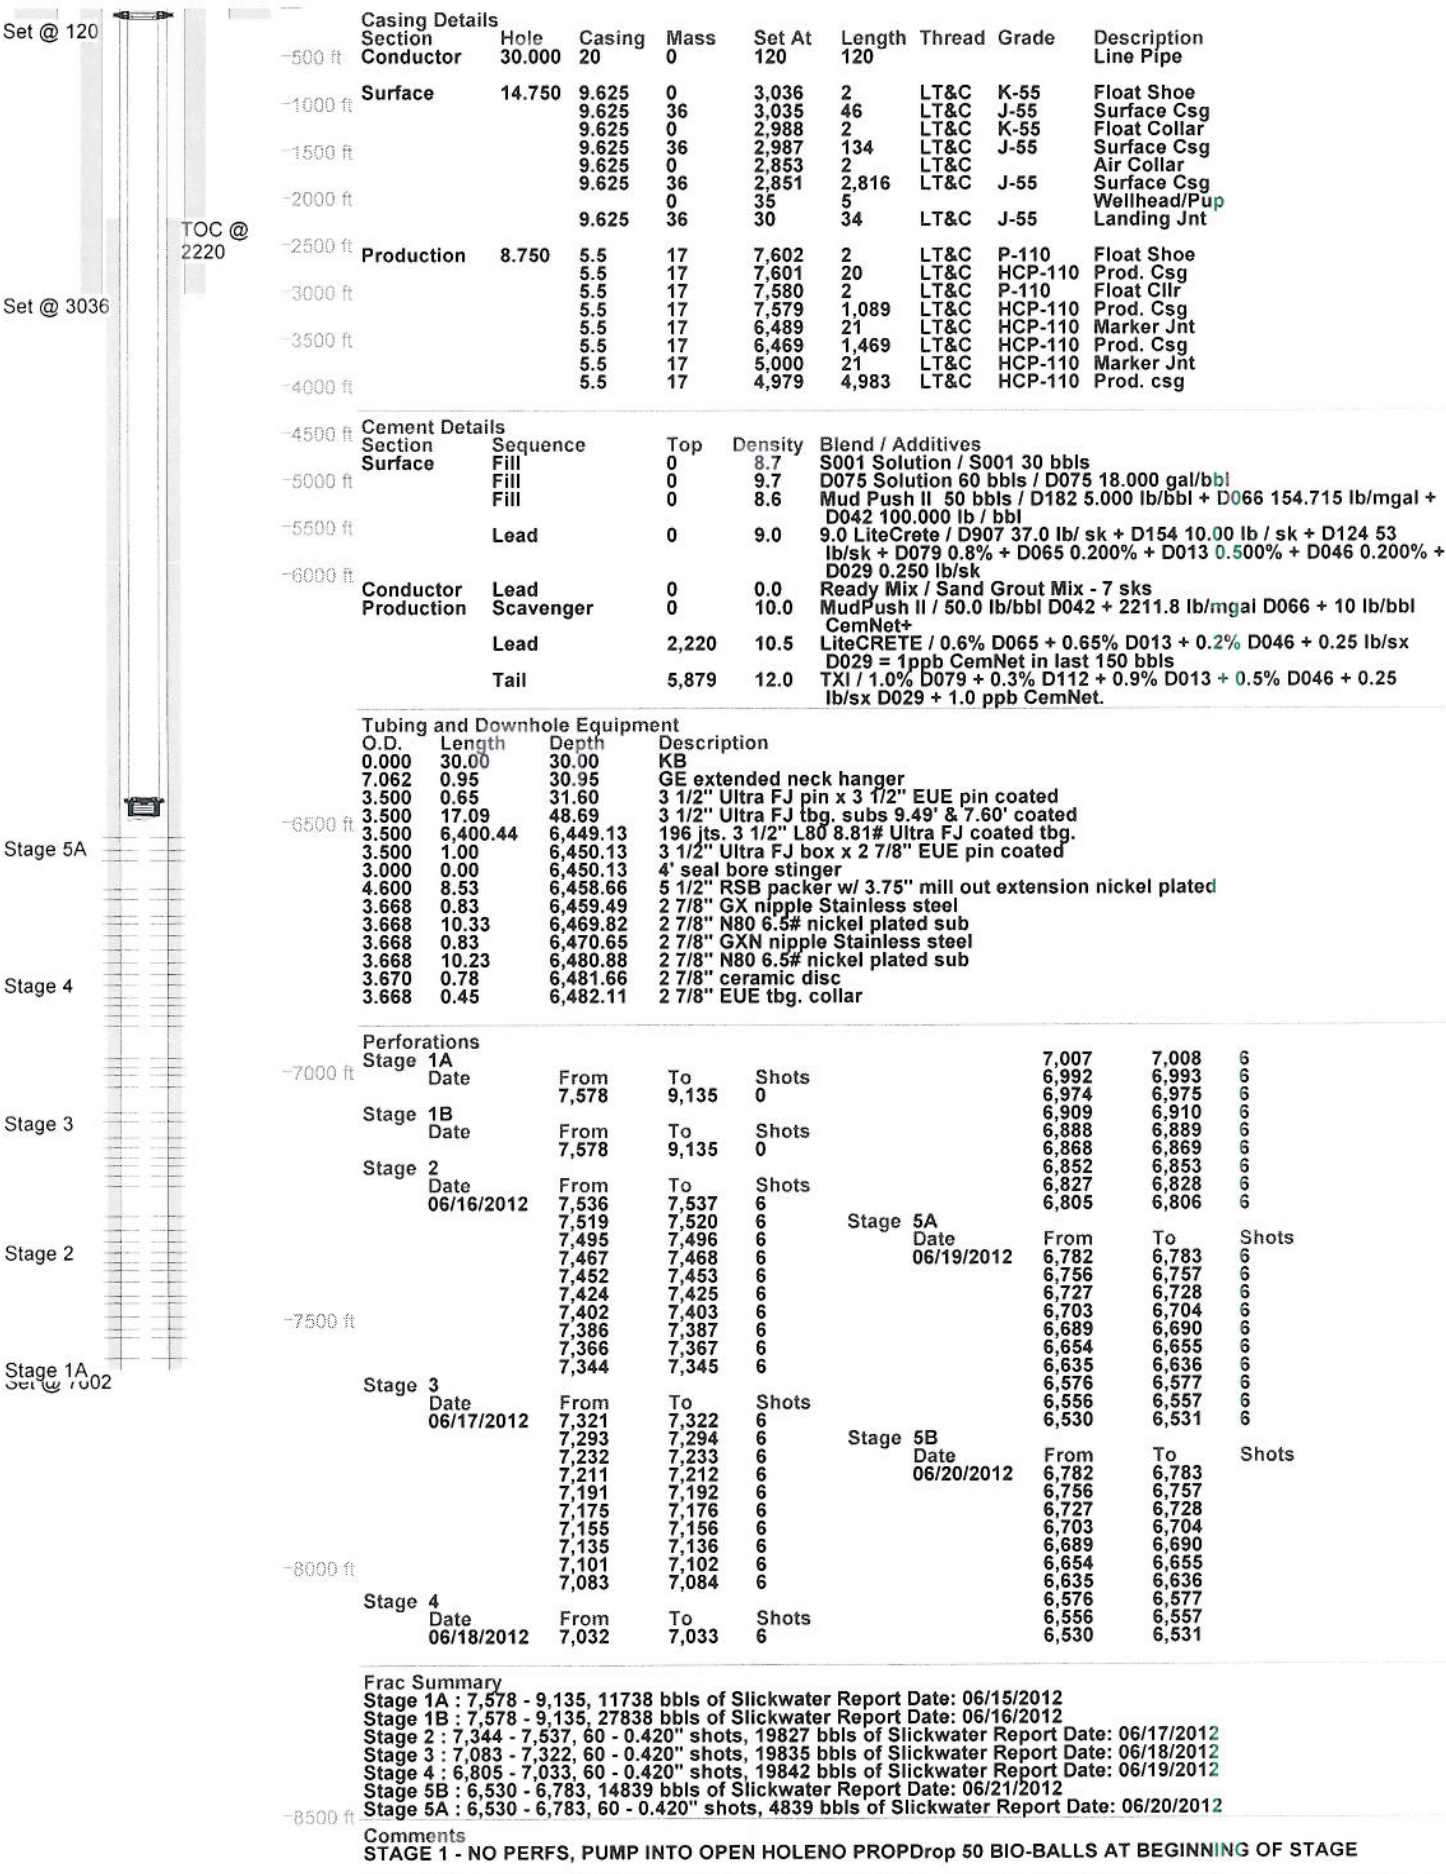

PBTD @ 7578  
TD @ 9135