

KERR-MCGEE ROCKY MOUNTAIN CORP

HSR-JMJ 3-30

NE NW 30 1N 62W 631' FNL 2,376' FWL

WELD,COLORADO

09/19/2012

AREA: N5

ROUTE: N55 Spud: 11/07/1997

WINS No.: 75480

AFE/WO#: 2032859

API#: 0512319482

GL: 4911

KB: 4923

MTD: 7250


TVD: 7250

LOG MD: 7238

PBMD: 7220

PBTVD: 7220

Directions: WCR 73 & WCR 8, S 1, E 1/4,S INTO

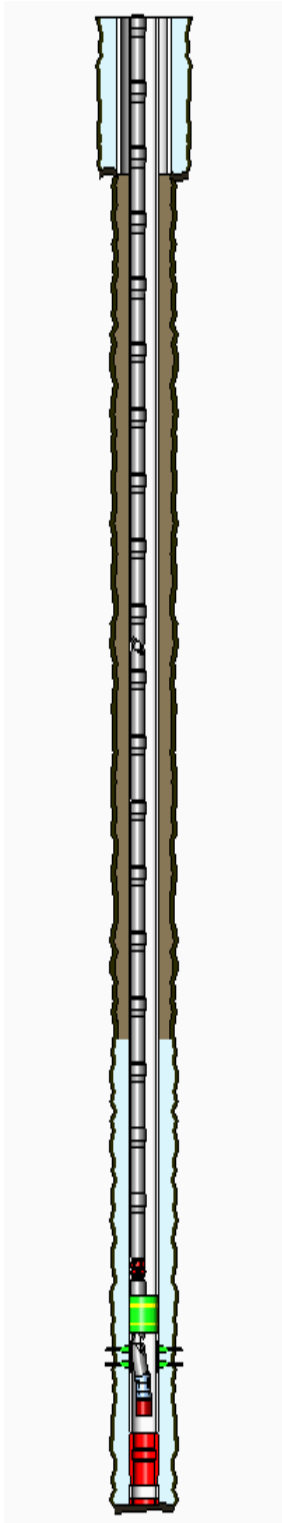

HOLE SECTIONS	Size	Top	Btm	TD Date
DRILL SURFACE HOLE	12.25	12	883	11/07/1997
PRODUCTION	7.88	883	7250	11/13/1997

TUBULARS	Tool Type	Joints	Size	Weight	Grade	Thread	Top D	Bottom D
SURFACE CASING	Casing	20	8.63	24.00	J-55	STC	12	883
PRODUCTION CASING	Casing	164	4.50	11.60	I-80	LTC	12	7221
	Float Collar	1	4.50				7221	7222
	Casing	1	4.50	11.60	I-80	LTC	7222	7230
	Casing Shoe	1	4.50				7230	7231
ROD STRING	Polished Rod	1	1.25				12	34
	Rod	97	0.88				34	2434
	Rod	186	0.75				2434	7084
	Rod	1	0.75				7084	7106
	Rod Pump	1	2.00				7106	7122
BRIDGE PLUG	CIBP With CMT Cap		4.50				7030	7032

CEMENT JOBS	Stage	Sacks	Cement Jobs	Top D	Btm D	cbl
SURFACE CASING	STAGE 1	610	G	12	873	No
PRODUCTION CASING	LEAD	220	DJ - G	5710	7250	Yes

PERFORATIONS	Formation	Zone	Top	Btm	Date	Reason	Comments
	D SAND		7085	7097	12/02/1997	PRODUCTION	

Comments: