




**Lease Name:** Wolfson 23-15

**Legals:** SWSE – Sec. 23, T4N, R67W

**County:** Weld County, Colorado

**API#:** 05-123-15029

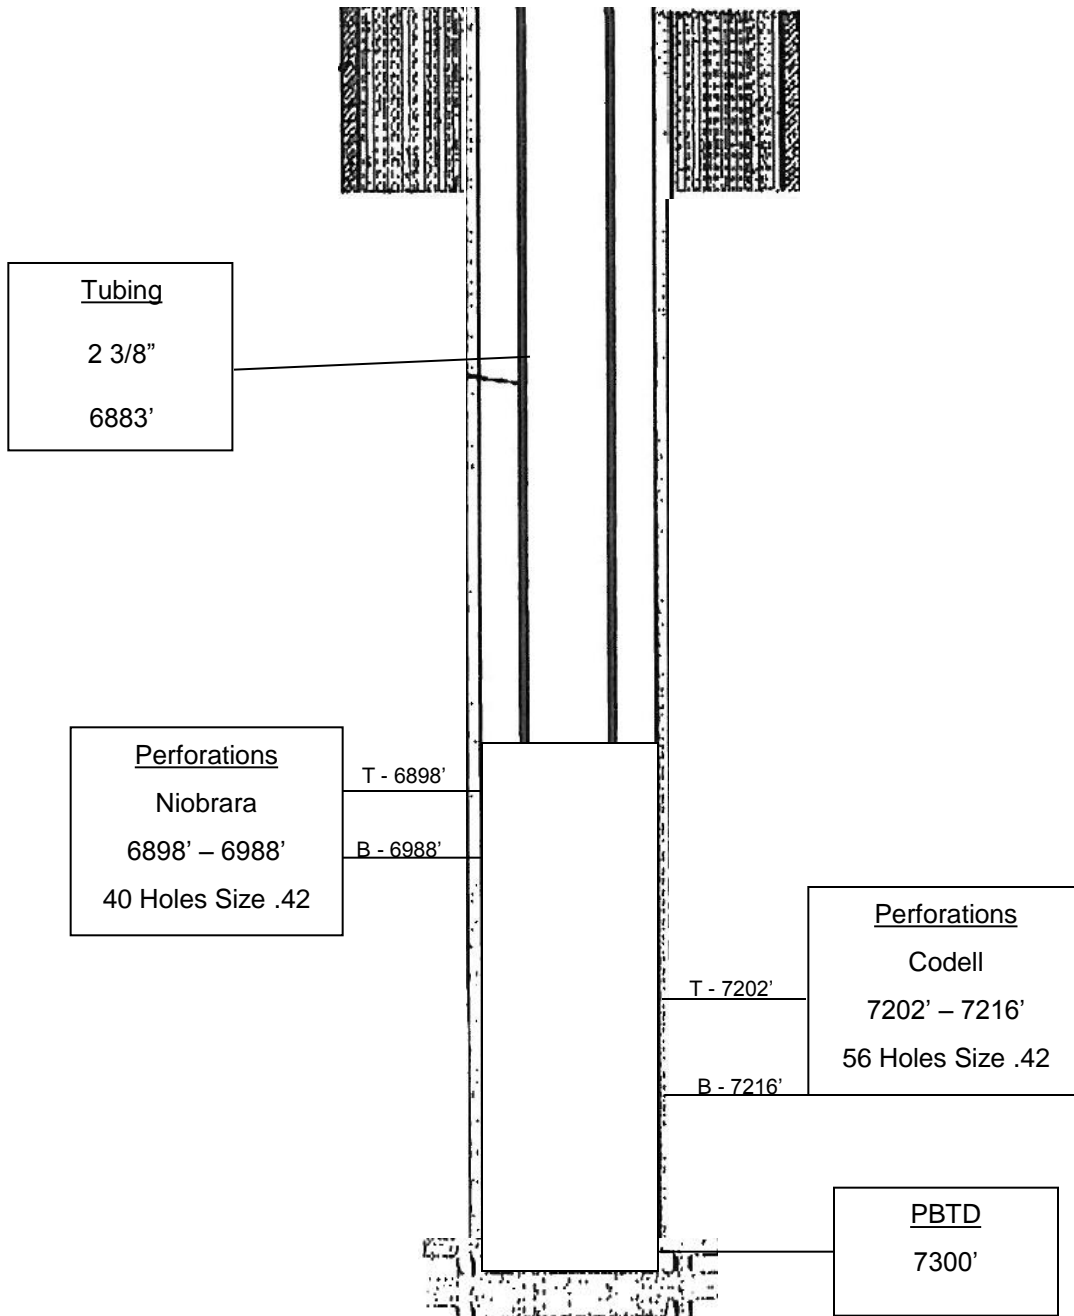

## Wellbore Diagram