




PDC Energy
 Armstead 2
 SWSW 31 2N 68W 6 PM
 Weld County, CO
 Current Wellbore - NOT TO SCALE!!!
 9/21/2012

API#: 05-123-09522

GL Elevation: 4950

KB Elevation: 0

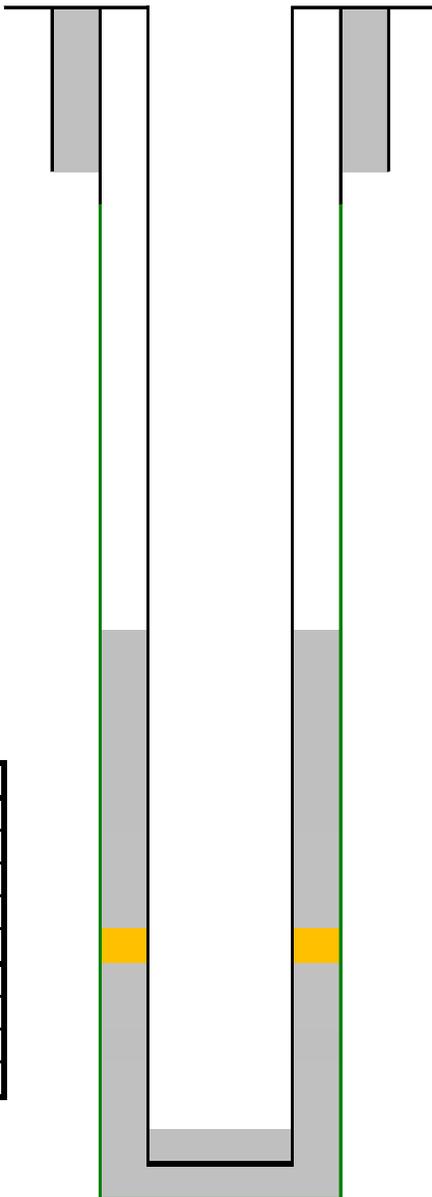

Surface Casing:
8 5/8" 24# @ 595' W/ 325 sks cmt.

Production Casing:
4 1/2" #11.6 @ 8413 w/ 325 sks cmt.

Perforations	
Old:	Shannon 4814-4836
	0
	0
	0
New:	0
	0
	0
	0

Longstring Cement:
1st stage: 325 sx
0
0
0

--

Top of Cement:
0 & 3280 (est)

Current Tubing In Hole:
0

Shannon

PBTD:	4925
Casing TD:	4925

NOTES