



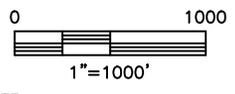

WELL LOCATION CERTIFICATE

THIS MAP DOES NOT REPRESENT A BOUNDARY SURVEY

SECTION: 6
TOWNSHIP: 6N
RANGE: 66W

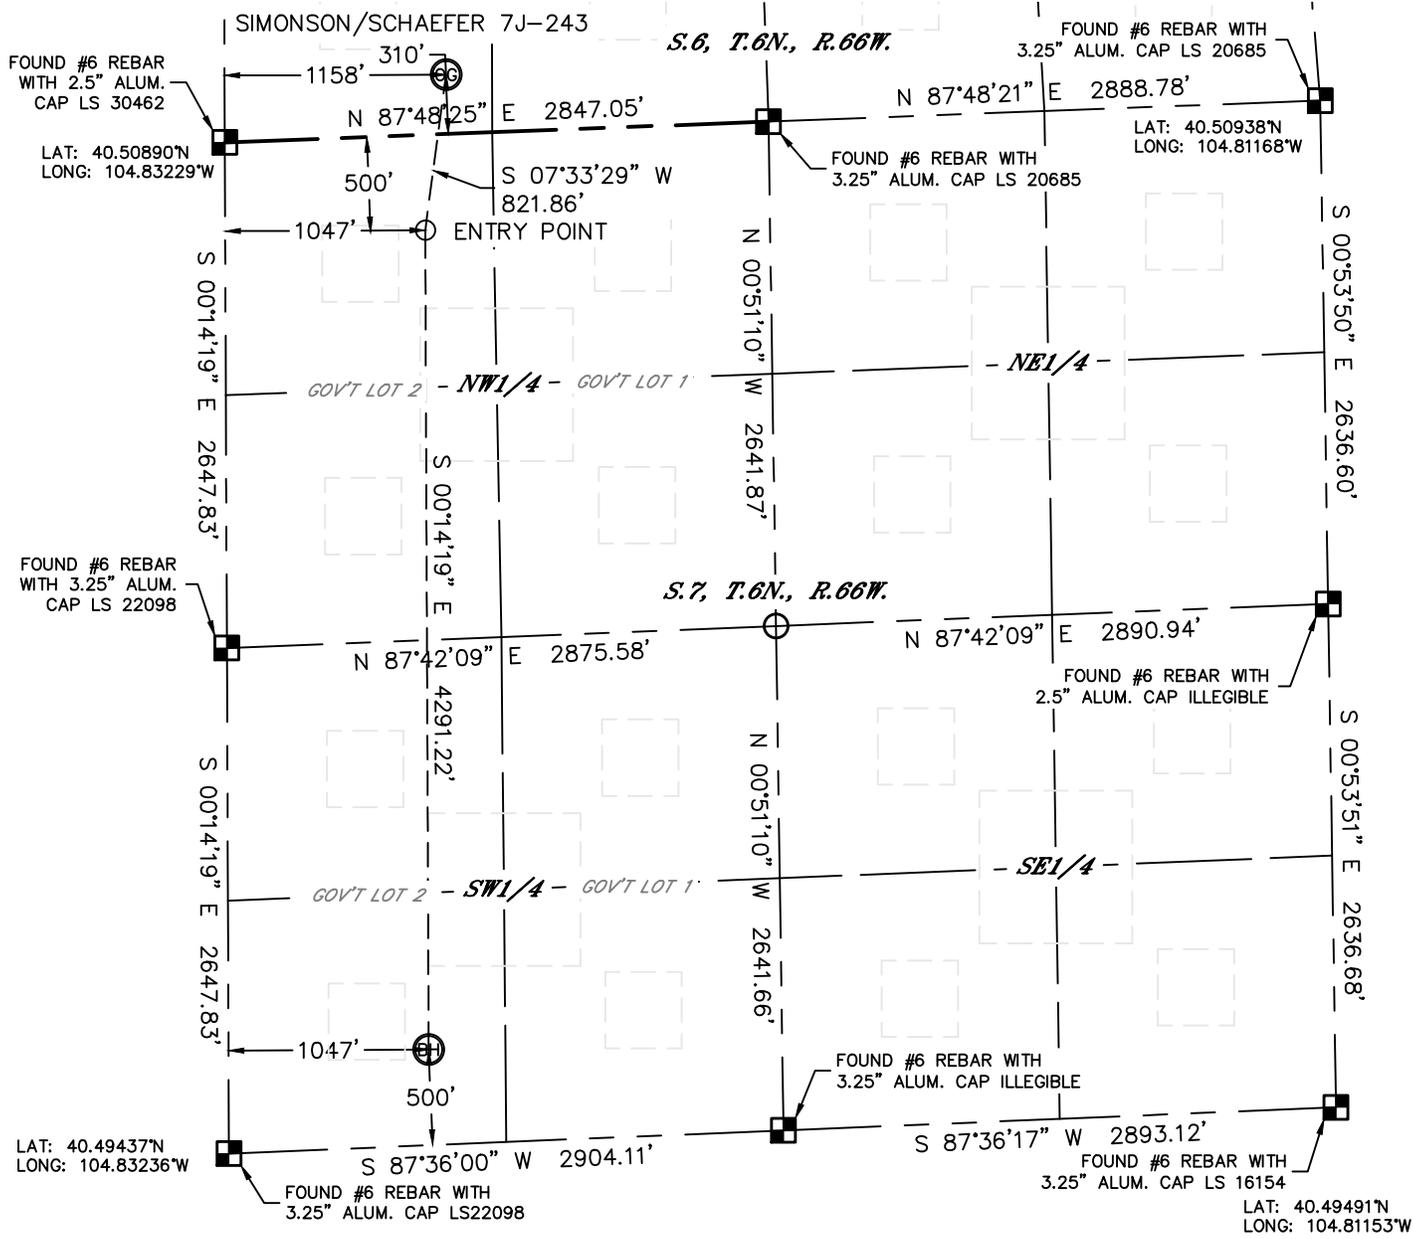


NOTE
According to Colorado law, you must commence any legal action based upon any defect in this W.L.C. within three years after you discover such defect. In no event, may any action based upon any defect in this survey be commenced more than ten years after the date of the certificate shown hereon. (13-80-105 C.R.S.)

- LEGEND**
-  = ALIQUOT MONUMENT AS DESCRIBED
 -  = CALCULATED POSITION

SHEET 2 OF 2

Brian T. Brinkman—On behalf of Lat40°, Inc.
 Colorado Licensed Professional Land Surveyor No. 38175
 DATE: 6/11/2012
 PROJECT#: 2010129

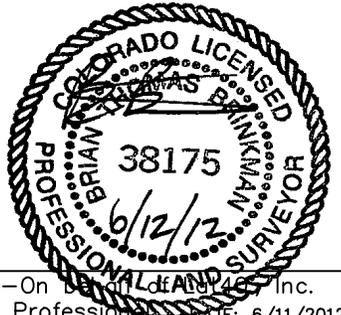




SITE SKETCH

SIMONSON/SCHAEFER 7J-243

SECTION: 6
TOWNSHIP: 6N
RANGE: 66W

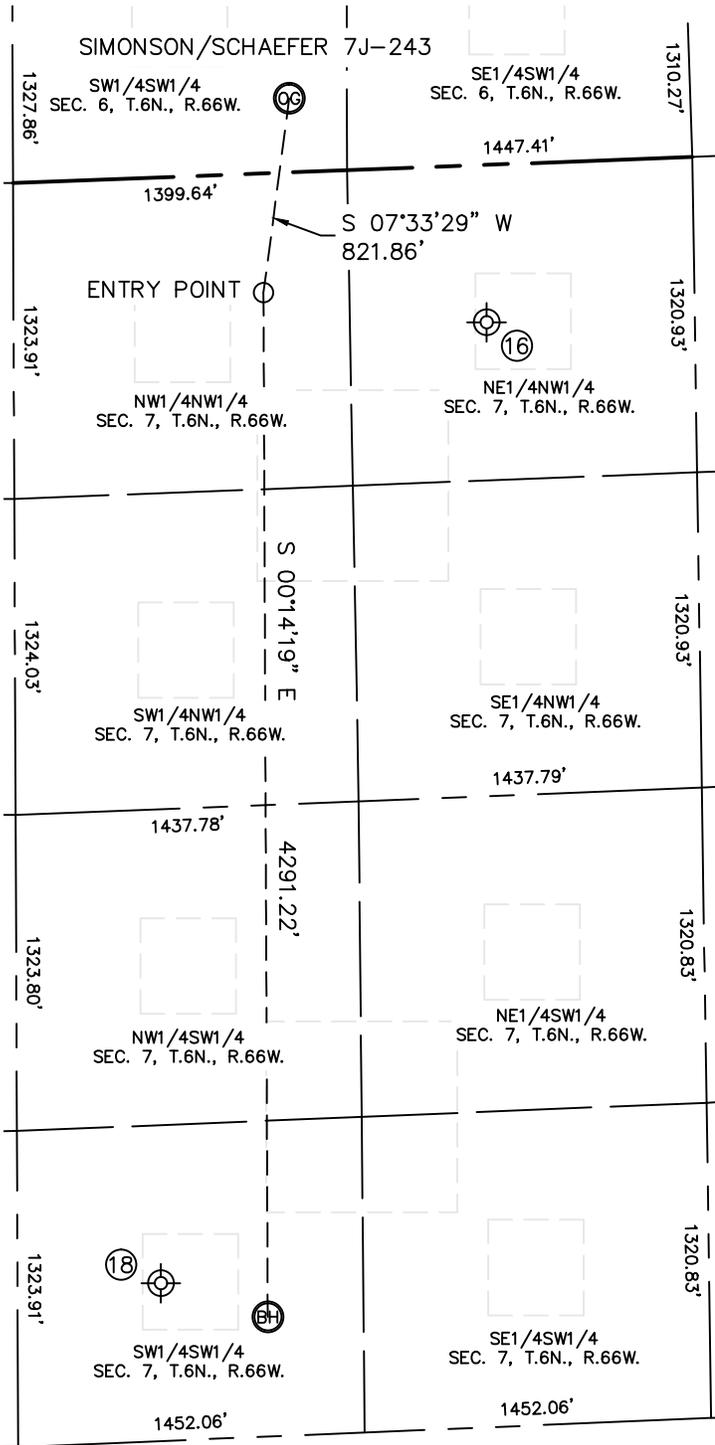

⑩
 SWANSON 1-7
 PLUGGED & ABANDONED
 NE1/4NW1/4
 660' FNL (COGCC)
 1980' FWL (COGCC)
 LAT-40.507223°N (COGCC)
 LONG-104.825094°W (COGCC)
 PDOP:N/A
 ELEV: 4888' (COGCC)

⑪
 HERBERT 1
 PLUGGED & ABANDONED
 SW1/4SW1/4
 660' FSL (COGCC)
 600' FWL (COGCC)
 LAT-40.496303°N (COGCC)
 LONG-104.830214°W (COGCC)
 PDOP:N/A
 ELEV: 4887' (COGCC)

