




Lat40°, Inc. 1635 Foxtrail Drive, Suite 325 Loveland, CO 970-776-3321

# WELL LOCATION CERTIFICATE

THIS MAP DOES NOT REPRESENT A BOUNDARY SURVEY

SECTION: 6  
TOWNSHIP: 6N  
RANGE: 66W

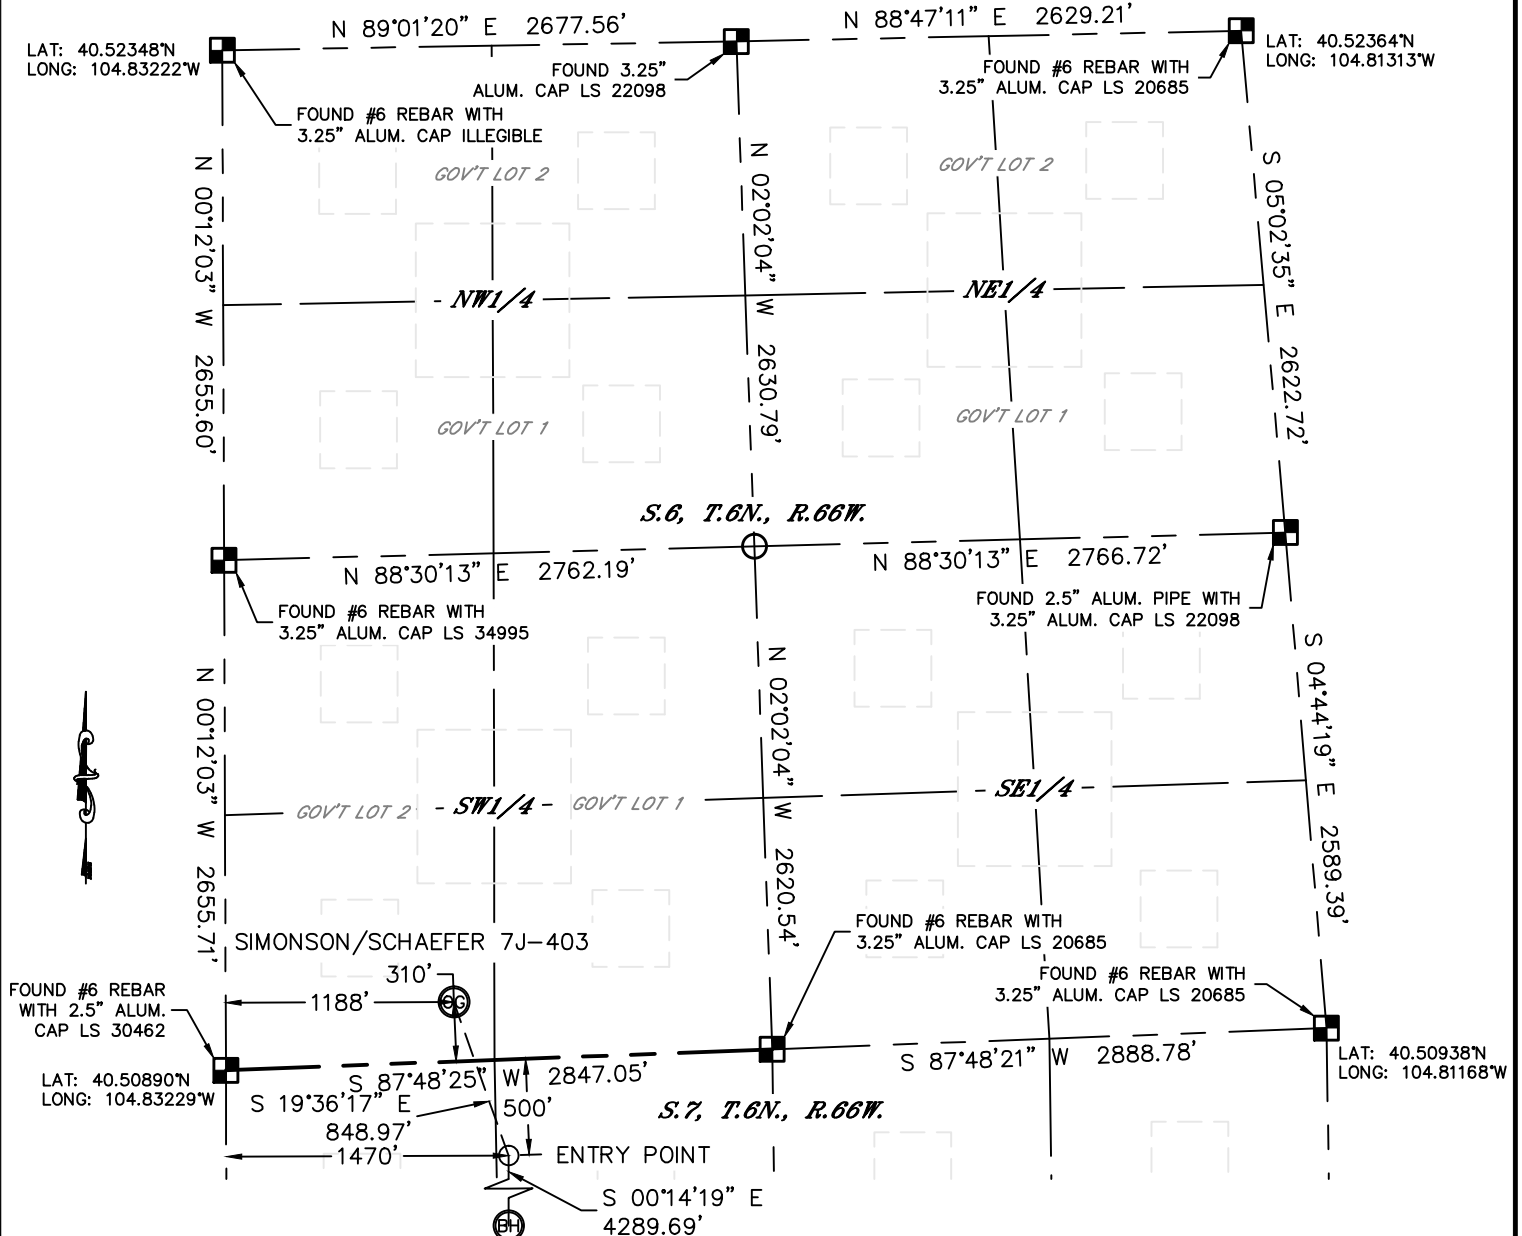

In accordance with a request from Al Bragg with PDC ENERGY Lat40°, Inc. has determined the surface location of the SIMONSEN/SCHAEFER 7J-403 to be 310' from the SOUTH line and 1188' from the WEST line as measured at right angles from the section lines of Section 6, Township 6 North, Range 66 West and the bottom hole to be 500' from the SOUTH line and 1470' from the WEST line as measured at right angles from the section lines of Section 7, Township 6 North, Range 66 West of the Sixth Principal Meridian, County of Weld, State of Colorado. I hereby state that this Well Location Certificate was prepared by me, or under my direct supervision, that the fieldwork was completed on 6/6/2012, for and on behalf of PDC ENERGY. That this is not a Land Survey Plat or an Improvement Survey Plat, and that it is not to be relied upon for establishment of fence, building, or other future improvement lines.

## NOTE:

- 1) Bearings shown are Grid Bearings of the Colorado State Plane Coordinate System, North Zone, North American Datum 1983/2007. The lineal dimensions as contained herein are based upon the "U.S. Survey Foot."
- 2) Ground elevations are based on an observed GPS elevation (NAVD 1988 DATUM).
- 3) IMPROVEMENTS: See LOCATION DRAWING for all visible improvements within 400' of disturbed area.
- 4) SURFACE USE: CROPLAND/PIVOT CORNER
- 5) INSTRUMENT OPERATOR: ADAM KELLY

## SURFACE LOCATION

LAT: 40.50985°N  
LONG: 104.82802°W  
PDOP: 1.9  
ELEV: 4891'  
1/4,1/4: SW1/4SW1/4 (GOV'T LOT 2)  
NEAREST PROPERTY LINE: 67' SW

## ENTRY POINT

LAT: 40.50765°N  
LONG: 104.82701°W

## BOTTOM HOLE

LAT: 40.49588°N  
LONG: 104.82707°W



1"=1000'

## LEGEND


- = ALIQUOT MONUMENT AS DESCRIBED
- = CALCULATED POSITION

## NOTE

According to Colorado law, you must commence any legal action based upon any defect in this W.L.C. within three years after you discover such defect. In no event, may any action based upon any defect in this survey be commenced more than ten years after the date of the certificate shown hereon. (13-80-105 C.R.S.)

## SHEET 1 OF 2

Brian T. Brinkman—On behalf of Lat40°, Inc.  
Colorado Licensed Professional Land Surveyor No. 38175  
DATE: 6/11/2012  
PROJECT#: 2010129

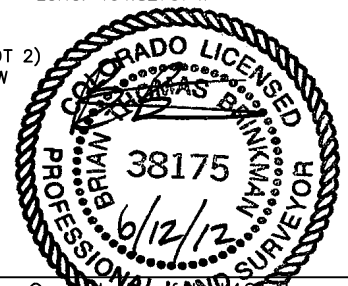





Lat40°, Inc. 1635 Foxtrail Drive, Suite 325 Loveland, CO 970-776-3321

# WELL LOCATION CERTIFICATE

THIS MAP DOES NOT REPRESENT A BOUNDARY SURVEY

SECTION: 6  
TOWNSHIP: 6N  
RANGE: 66W

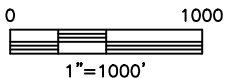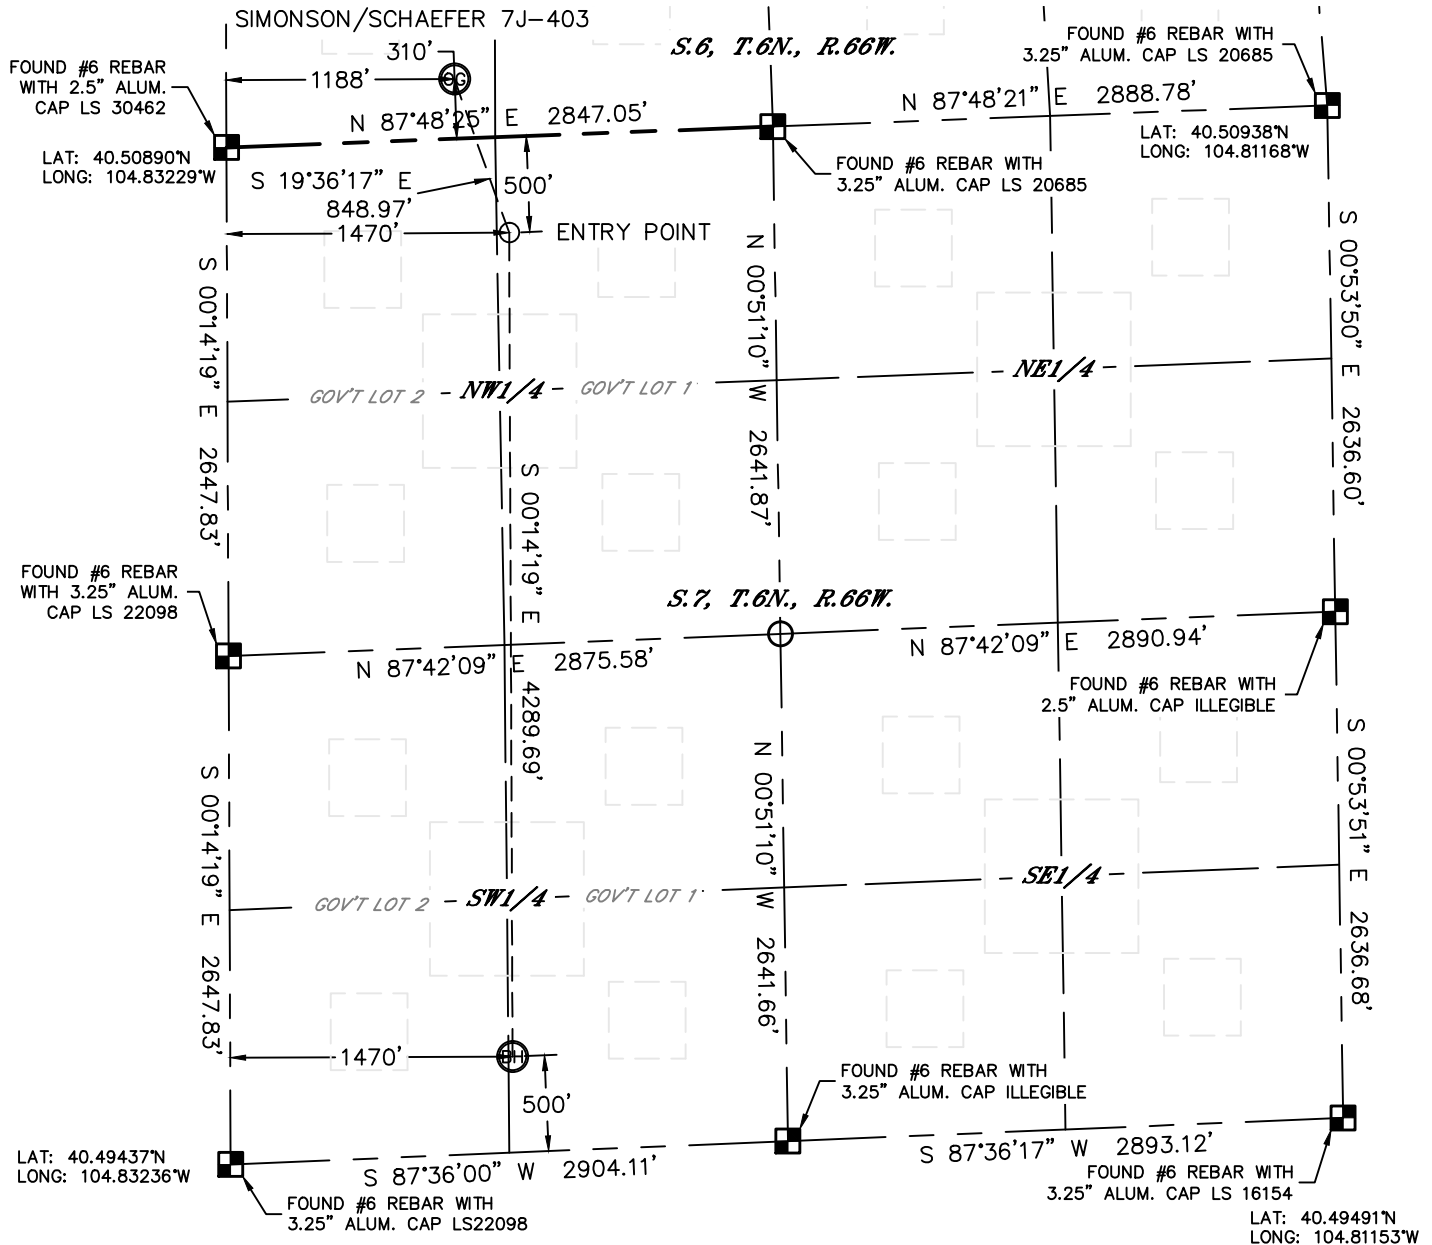

## NOTE


According to Colorado law, you must commence any legal action based upon any defect in this W.L.C. within three years after you discover such defect. In no event, may any action based upon any defect in this survey be commenced more than ten years after the date of the certificate shown hereon. (13-80-105 C.R.S.)

## LEGEND

- = ALIQUOT MONUMENT AS DESCRIBED
- = CALCULATED POSITION

SHEET 2 OF 2

Brian T. Brinkman—On behalf of Lat40°, Inc.  
Colorado Licensed Professional Land Surveyor No. 38175  
DATE: 6/11/2012  
PROJECT#: 2010129

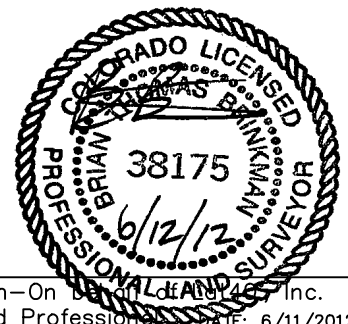




Lat40°, Inc. 1635 Foxtrail Drive, Suite 325 Loveland, CO 970-776-3321

# SITE SKETCH

SIMONSON/SCHAEFER 7J-403

SECTION: 6  
TOWNSHIP: 6N  
RANGE: 66W

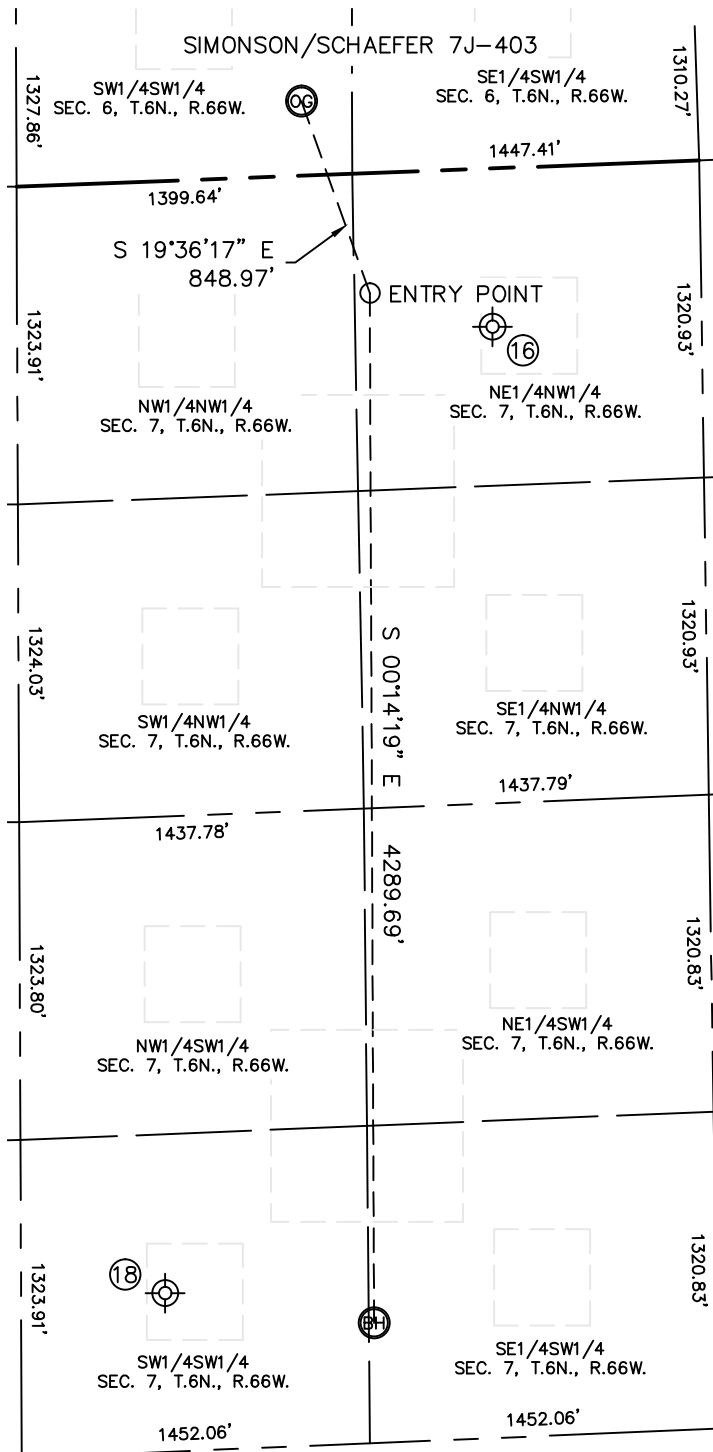


⑩

SWANSON 1-7  
PLUGGED & ABANDONED  
NE1/4NW1/4  
660' FNL (COGCC)  
1980' FWL (COGCC)  
LAT-40.507223°N (COGCC)  
LONG-104.825094°W (COGCC)  
PDOP:N/A  
ELEV: 4888' (COGCC)

⑪

HERGERT 1  
PLUGGED & ABANDONED  
SW1/4SW1/4  
660' FSL (COGCC)  
600' FWL (COGCC)  
LAT-40.496303°N (COGCC)  
LONG-104.830214°W (COGCC)  
PDOP:N/A  
ELEV: 4887' (COGCC)

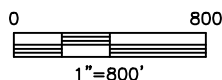

DATE: 6/11/2012  
PROJECT#: 2010129