


Received 9/4/2012 Rifle COGCC
Re spill 2230213

Notes: Site sampled on 8/10/2012
Two samples taken from containers
holding soils for disposal

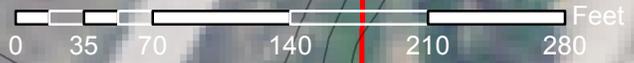

30

29

Background sample- sampling depth 16"

Subsoil #2- sampling depth 24"

Subsoil #1- sampling depth 24"



SG Interests I, Ltd.
1485 Florida Rd Suite 202
Durango, CO 81301

Jacobs 29-1, Rept. Tracking No. 2230213

SG Interests I, Ltd.
Gunnison County, Colorado



2011 NAIP Aerial Photograph

Date: September 2012

Scale: 1:1,150