

WPX Energy Rocky Mountain, LLC

Federal RGU 422-25-198

Sulphur Creek Field

SHL 2182' FNL 1755' FEL (SW/4 NE/4) BHL 2242' FNL 1910' FWL (SE/4 NW/4)

Section 25-T1S-R98W 6th PM

Garfield County, Colorado

Formation Tops

(Measured Depths)

Mesaverde @ 8016'

Cameo @ 11086'

Rollins @ 11667'

Cozzette @ 11801'


Corcoran @ 12029'

Sego @ 12352'

PBTD @ 12857'

TMD @ 12885'

TVD @ 12731'

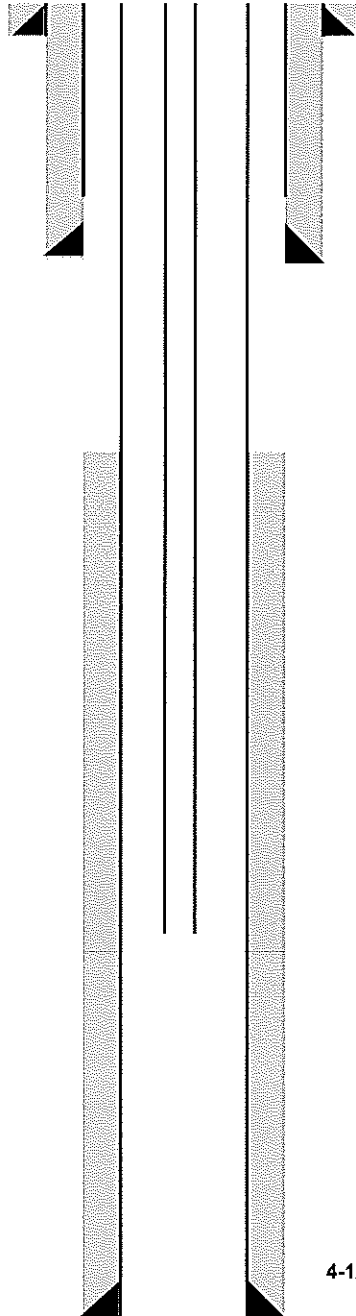

Conductor 30" Hole 18" casing/liner 80' W/135 sks cmt

Cmt @ Surface - (Cmt circ to surf during cmt job)

9 5/8" 32.3# ppf Csg. Set @ 4002'

In 14 1/4" Hole W/1956 Sks. Cmt

Top Of Cement 6160'

10253-10294' Mesaverde

10343-10588' Mesaverde

10642-10856' Mesaverde

10944-11155' Mesaverde

11184-11333' Cameo

11378-11570' Cameo

11985-11986' Cozzette

12045-12330' Corcoran

12368-12483' Sego

12511-12685' Sego

4-1/2", 11.6 ppf. Csg. Set @ 12875' W/ 1720 sks Cmt