

Murphy #31-3

Latitude/Longitude: N39.65634800, W -104.47471200:


Township/Range: 31 004-S

Nese, Sec. 31, T4S-R63W, Arapahoe Co.

County: Arapahoe, State: CO

Spud Date: 12/24/1987

Total Depth: 8113

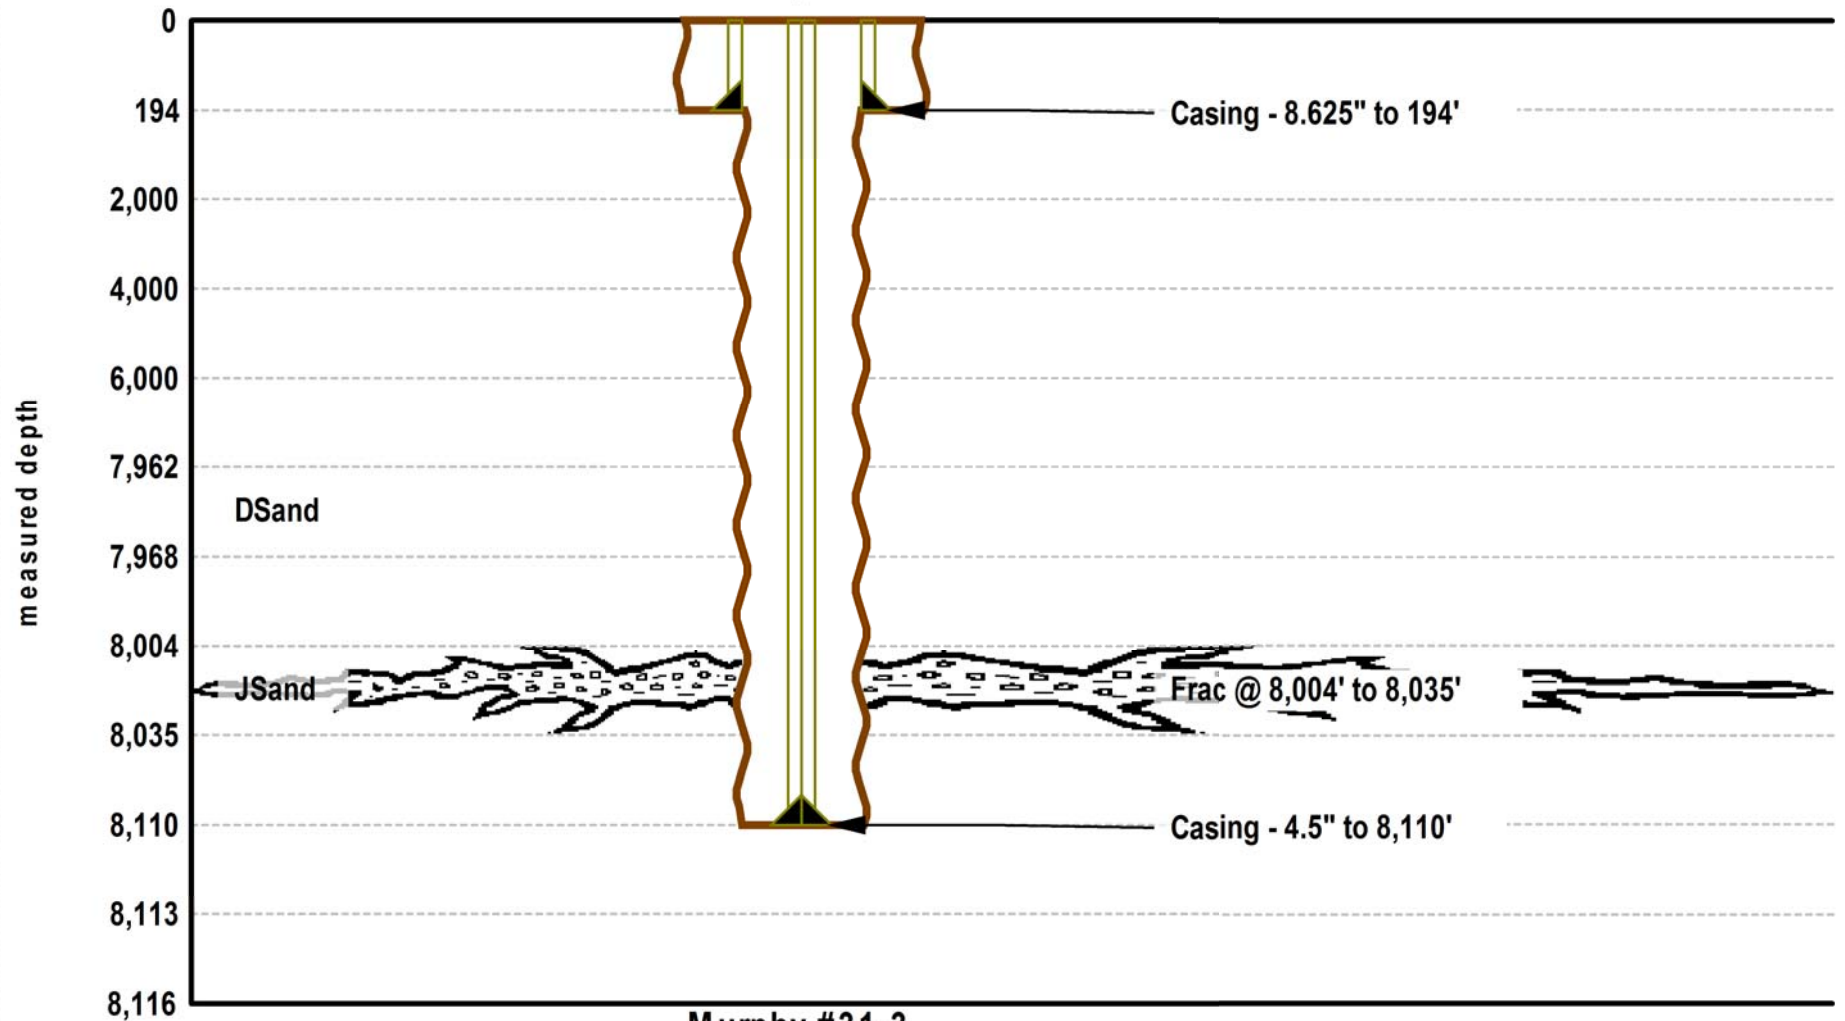

Murphy #31-3

Initial Completion: 4/25/1988

Proposed Depth: 0 Plug Back Depth: 8070