

WPX Energy Rocky Mtn LLC

RWF 42-34

API #05-045-20452-00

1999' FNL x 531' FWL - SHL


(SWNW) Sec. 35-T6S-R94W

1324' FNL x 822' FEL - BHL

(SENE) Sec. 34-T6S-T94W

Garfield County, Colorado

FINAL

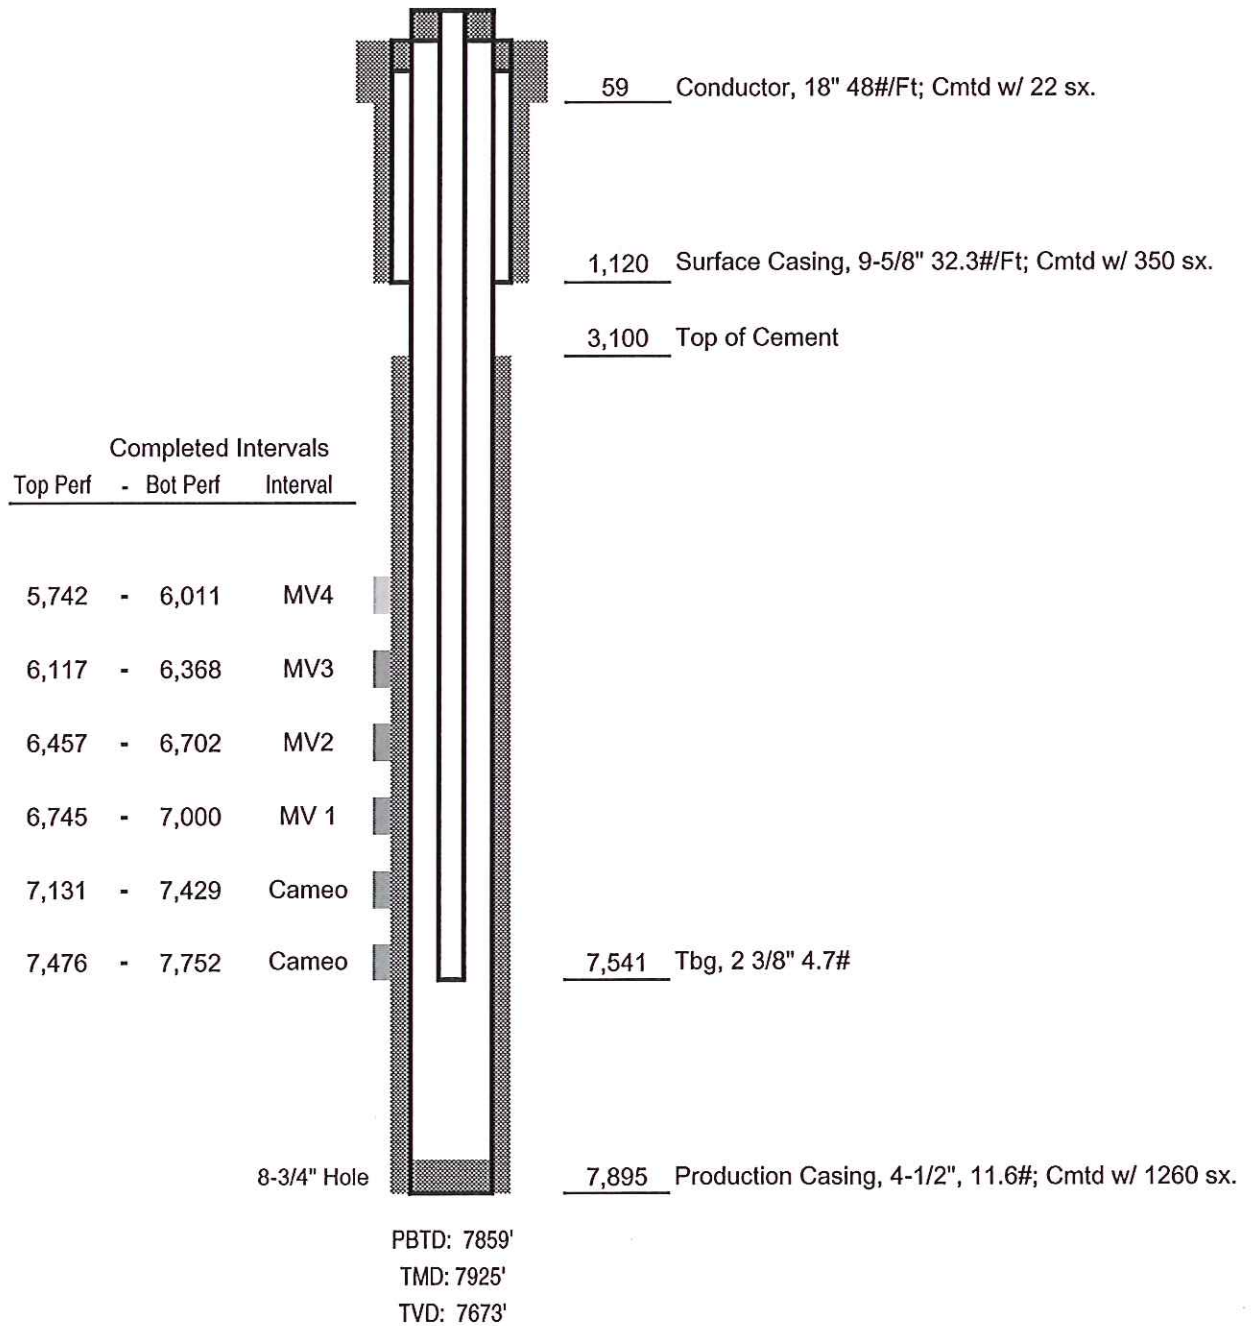

Not to Scale