


**WPX Energy Rocky Mountain Company, LLC  
Jolley KP 524-8  
Kokopelli Field**

**SHL 188' FSL 2326' FWL (SE/4 SW/4) BHL 228' FSL 1945' FWL (SE/4 SW/4)  
Section 8, T6S, R91W 6TH PM  
Williams Production RMT Co.  
Garfield County, Colorado**

**Formation Tops  
(Measured Depths)**

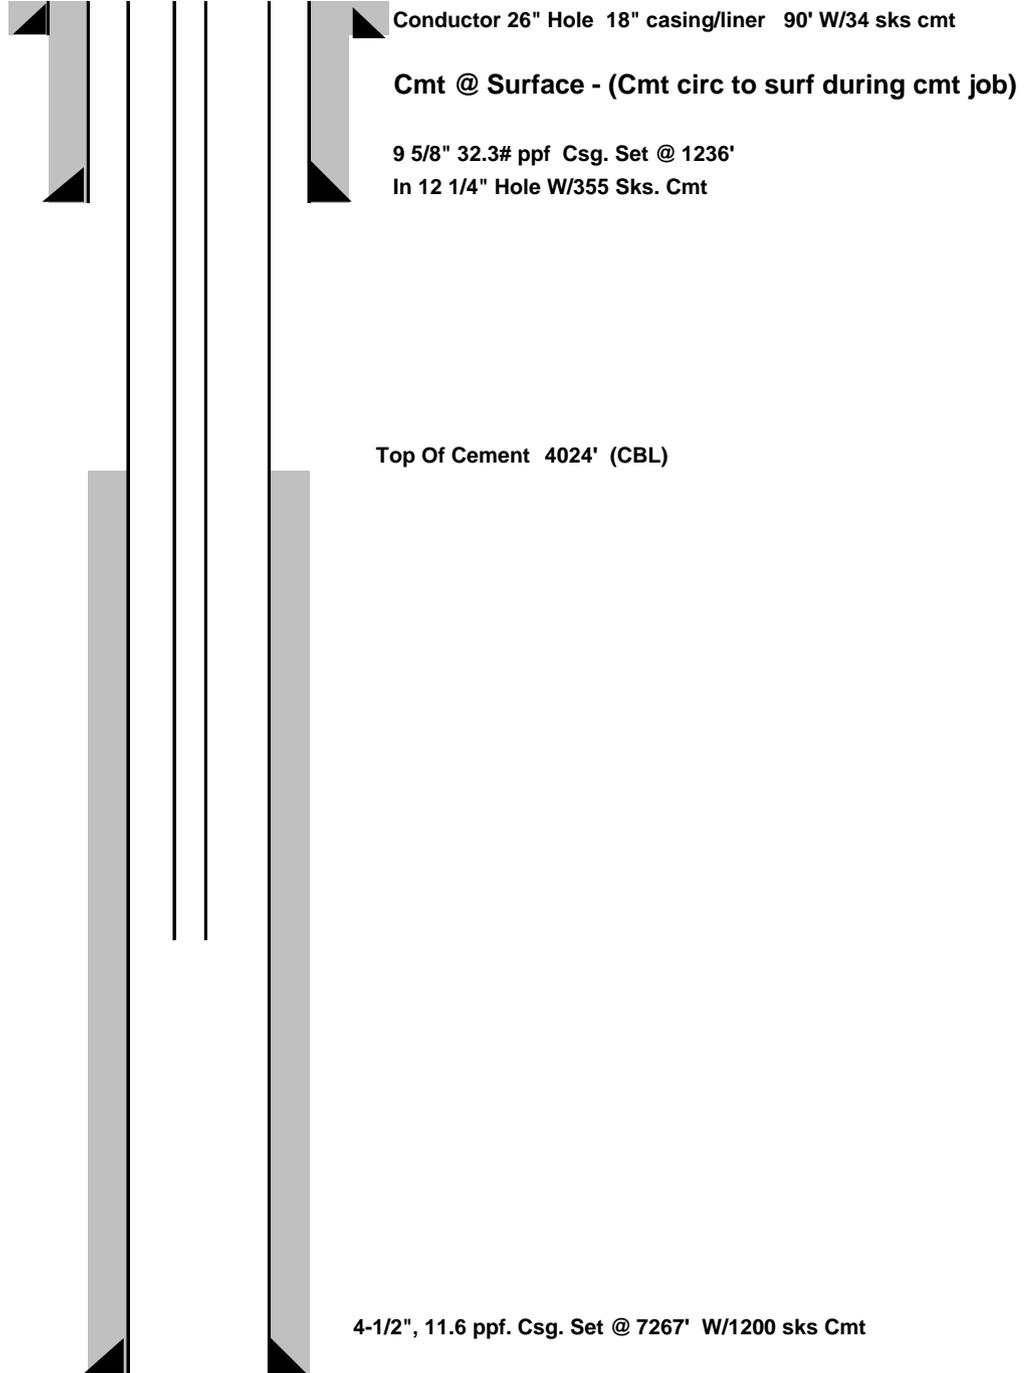

**PBTD @  
TMD @ 7283'  
TVD @ 7261'**