

WPX Energy Rocky Mtn LLC

RWF 34-27

API #05-045-19832-00


456' FSL x 2164' FEL - SHL

681' FNL x 2133' FEL - BHL

(SWSE) Sec. 27-T6S-R94W

Garfield County, Colorado

PRELIMINARY

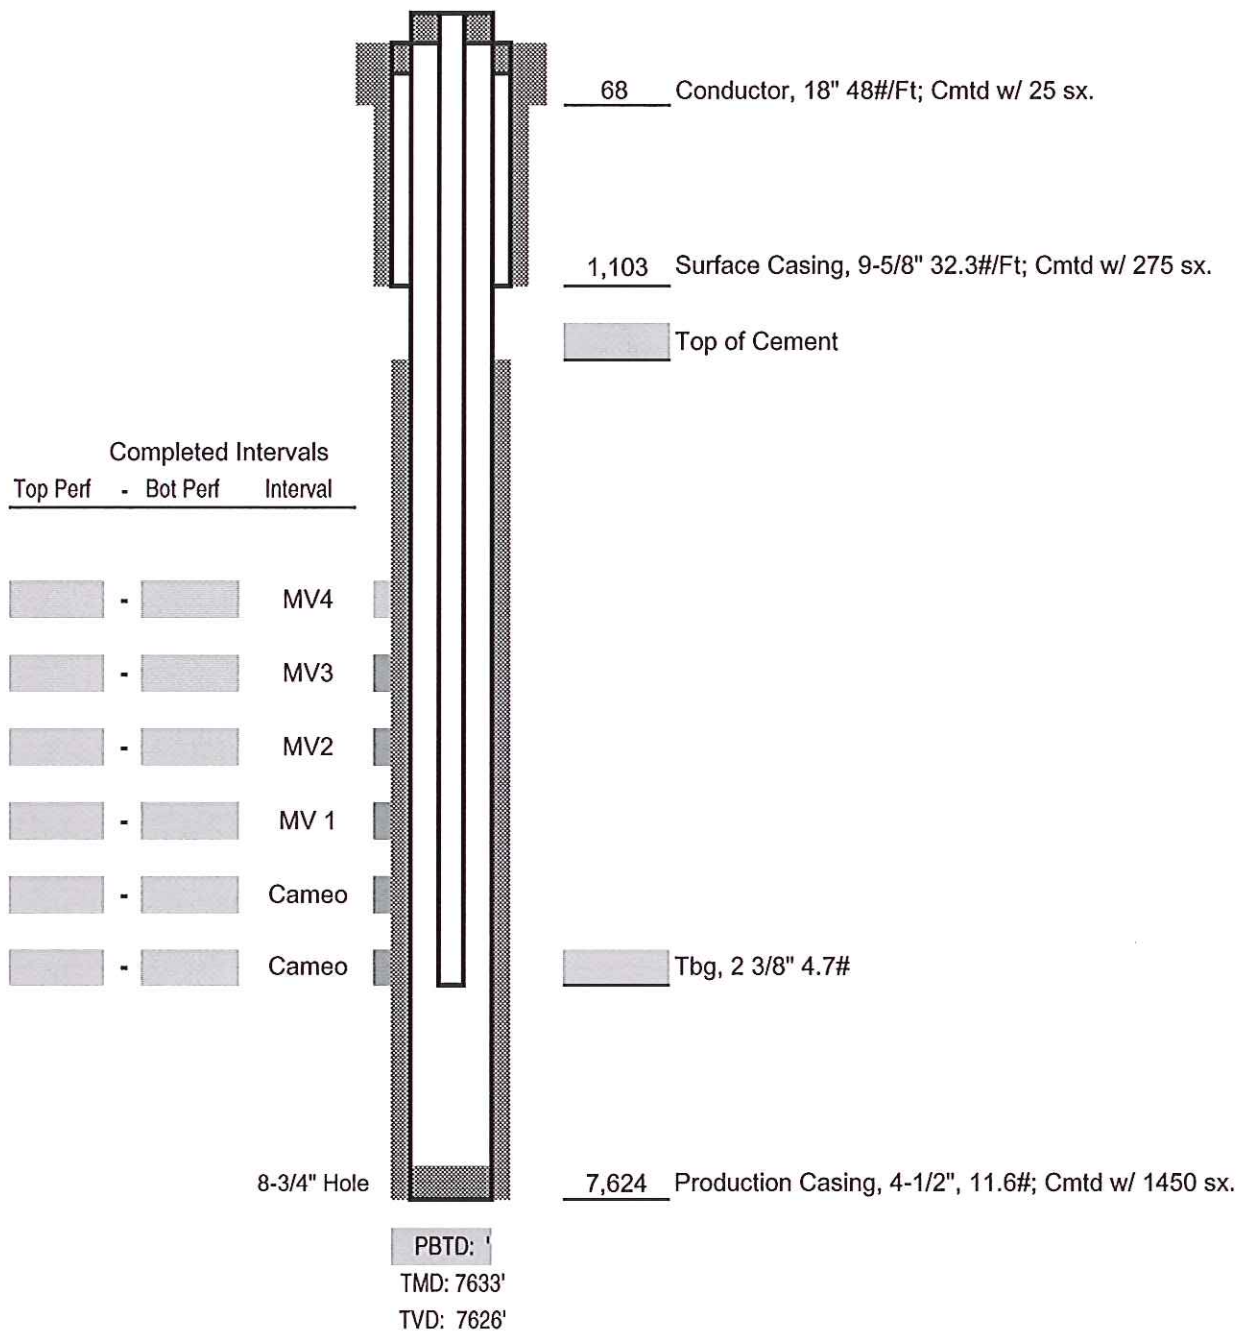

Not to Scale