


WELL LOCATION CERTIFICATE

THIS MAP DOES NOT REPRESENT A BOUNDARY SURVEY

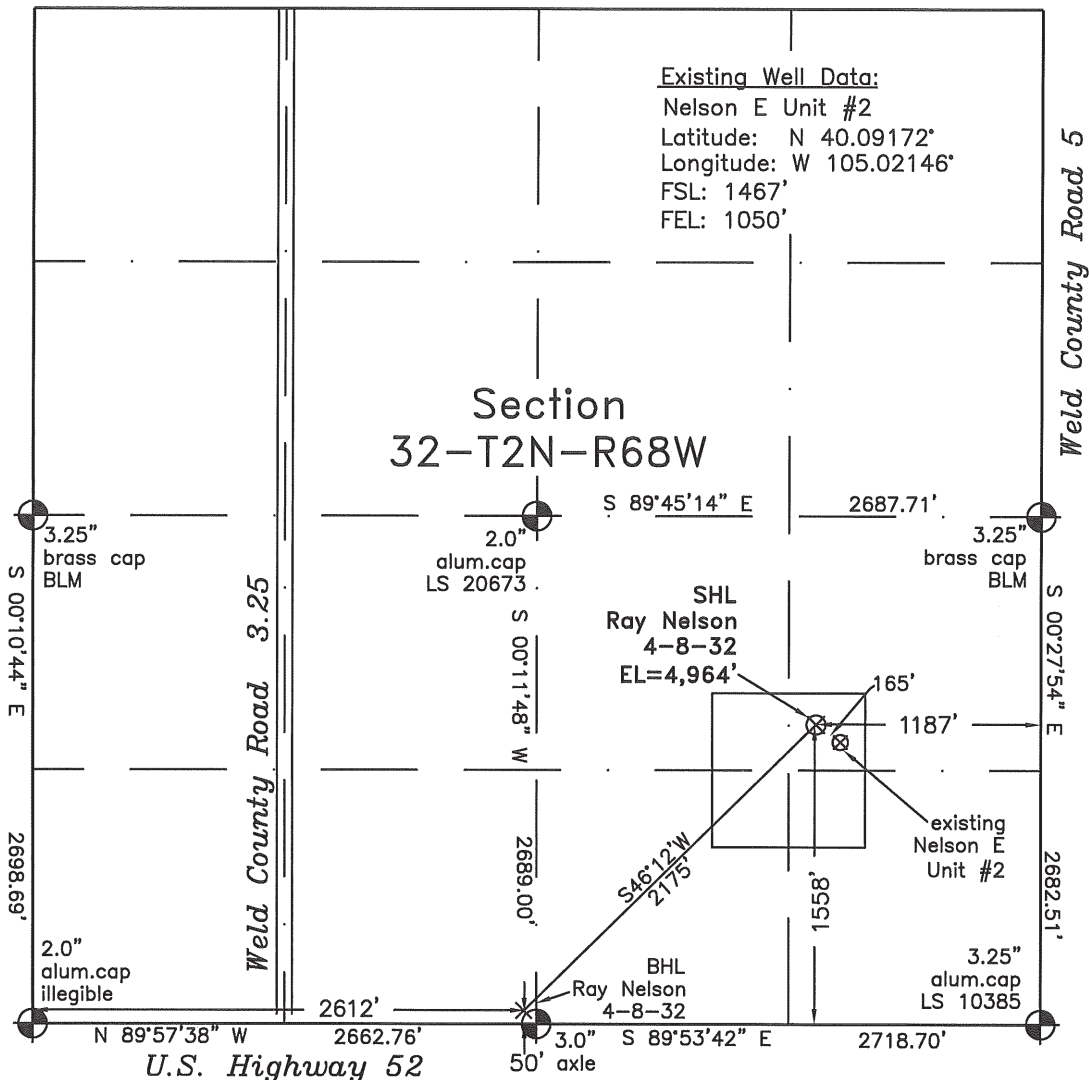

Scale 1" = 1000'

1000'

approximate scale

LEGEND

— found survey monument

- - - improved road

- - - calculated dimension