WPX Energy Rocky Mountain, LLC
Federal RGU 22-25-198
Sulphur Creek Field
SHL 2163' FNL 1731' FEL (SW/4 NE/4) BHL 1573' FNL 1859' FWL (SE/4 NW/4)
Section 25-T1S-R98W 6th PM
Garfield County, Colorado

Formation Tops
(Measured Depths)

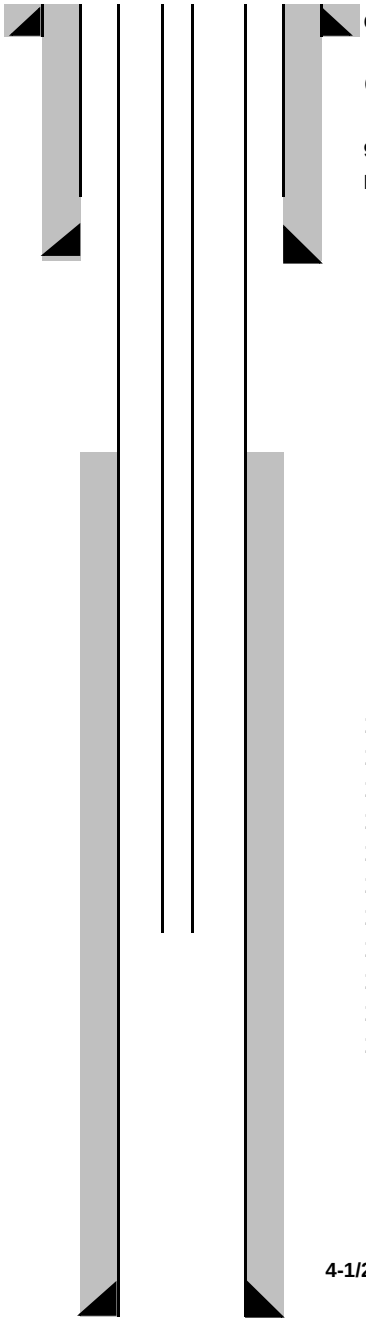

Conductor 30" Hole 18" casing/liner 80' W/135 sks cmt

Cmt @ Surface - (Cmt circ to surf during cmt job)

9 5/8" 36# ppf Csg. Set @ 3995'
In 14 3/4" Hole W/1831 Sks. Cmt

Top Of Cement 5602'

Mesaverde @ 8073'

Cameo @ 11131'

Rollins @ 11730'

Cozzette @ 11863'

Corcoran @ 12089'

Sego @ 12420'

10124-10415' Mesaverde
10482-10648' Mesaverde
10794-10900' Mesaverde
11002-11218' Mesaverde/Cameo
11281-11429' Cameo
11481-11634' Cameo
12081-12082' Cozzette
12113-12286' Corcoran
12326-12411' Corcoran
12437-12650' Sego
12699-12815' Sego

PBTD @ 12908'
TMD @ 12952'
TVD @ 12767'

4-1/2", 11.6 ppf. Csg. Set @ 12933' W/ 1710 sks Cmt