

KERR-MCGEE ROCKY MOUNTAIN CORP

UPRR 21 PAN AM "E" #1

SE SE 7 4N 65W -- --

WELD,COLORADO

10/03/2012

AREA: N1

ROUTE: N15 Spud: 09/14/1976

WINS No.: 76424

AFE/WO#: 2053607

API#: 0512308925

GL:

KB:

MTD: 4550

TVD: 4550


LOG MD: 4540

PBMD: 4500

PBTVD: 4500

Directions:

WCR 46 & WCR 39, N 2/10, W 2/10 INTO.

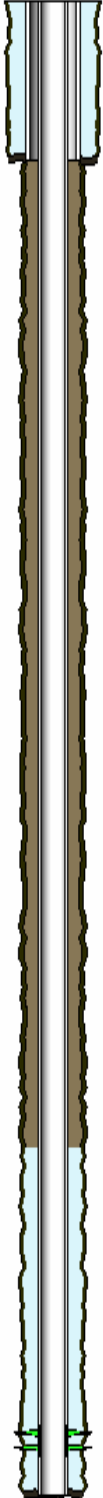

<u>HOLE SECTIONS</u>	<u>Size</u>	<u>Top</u>	<u>Btm</u>	<u>TD Date</u>					
SURFACE	12.25	0	487						
PRODUCTION	7.88	487	4550						
<u>TUBULARS</u>	<u>Tool Type</u>	<u>Joints</u>	<u>Size</u>	<u>Weight</u>	<u>Grade</u>	<u>Thread</u>	<u>Top D</u>	<u>Bottom D</u>	
8 5/8 IN CASING	Casing	2	8.63	24.00			0	487	
4 1/2 IN CASING	Casing	2	4.50	11.60			0	4549	
<u>CEMENT JOBS</u>	<u>Stage</u>	<u>Sacks</u>	<u>Cement Jobs</u>				<u>Top D</u>	<u>Btm D</u>	<u>cbl</u>
8 5/8 IN CASING	PRIMARY	325	LEAD	CEMENT			0	487	No
	SURFACE TOPOUT	100	TAIL-1	CEMENT			0	487	No
4 1/2 IN CASING	PRIMARY	200	LEAD	CEMENT			3540	4549	No
4 1/2 IN CASING							0	0	No
4 1/2 IN CASING							0	0	No
--None--							0	0	No
--None--							0	0	No
--None--							0	0	No
--None--							0	0	No
<u>PERFORATIONS</u>	<u>Formation</u>	<u>Zone</u>	<u>Top</u>	<u>Btm</u>	<u>Date</u>	<u>Reason</u>	<u>Comments</u>		
	SUSSEX		4400	4426	09/21/1976		JET		

Comments: