

KERR-MCGEE ROCKY MOUNTAIN CORP

HSR-LLOYD CAMP 13-31

SW SW 31 3N 65W -- --

WELD,COLORADO

10/03/2012

AREA: N5

ROUTE: N51 Spud: 07/07/1994

WINS No.: 76933

AFE/WO#: 88219138

API#: 0512318280

GL: 4976

KB: 4986

MTD: 7511


TVD: 7511

LOG MD:

PBMD: 7400

PBTVD: 7400

Directions: WCR 28 & WR 39, W 1, S 3/4, E INTO

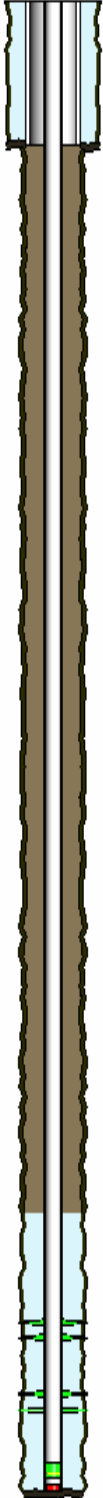

<u>HOLE SECTIONS</u>		<u>Size</u>	<u>Top</u>	<u>Btm</u>	<u>TD Date</u>
SURFACE		12.25	10	790	07/07/1994
PRODUCTION		7.88	790	7511	07/11/1994

<u>TUBULARS</u>	<u>Tool Type</u>	<u>Joints</u>	<u>Size</u>	<u>Weight</u>	<u>Grade</u>	<u>Thread</u>	<u>Top D</u>	<u>Bottom D</u>
SURFACE CASING	Casing	18	8.63	24			10	783

<u>CEMENT JOBS</u>	<u>Stage</u>	<u>Sacks</u>	<u>Cement Jobs</u>	<u>Top D</u>	<u>Btm D</u>	<u>cbl</u>
SURFACE CASING	STAGE 1	548	NEAT	10	783	No
PRODUCTION CASING	STAGE 1	180	PREMIUM	6580	7511	Yes
PRODUCTION CASING				0	0	No
--None--				0	0	No
SURFACE CASING				0	0	No
SURFACE CASING				0	0	No

<u>PERFORATIONS</u>						
<u>Formation</u>	<u>Zone</u>	<u>Top</u>	<u>Btm</u>	<u>Date</u>	<u>Reason</u>	<u>Comments</u>
NIOBRARA		7135	7138	07/18/1994	PRODUCTION	
CODELL		7359	7369	06/04/2001	PRODUCTION	
CODELL		7360	7363	07/18/1994	PRODUCTION	

Comments: