Well Name: Dixon Federal 12D-23-692 Before P & A

Bill Barrett Corporation

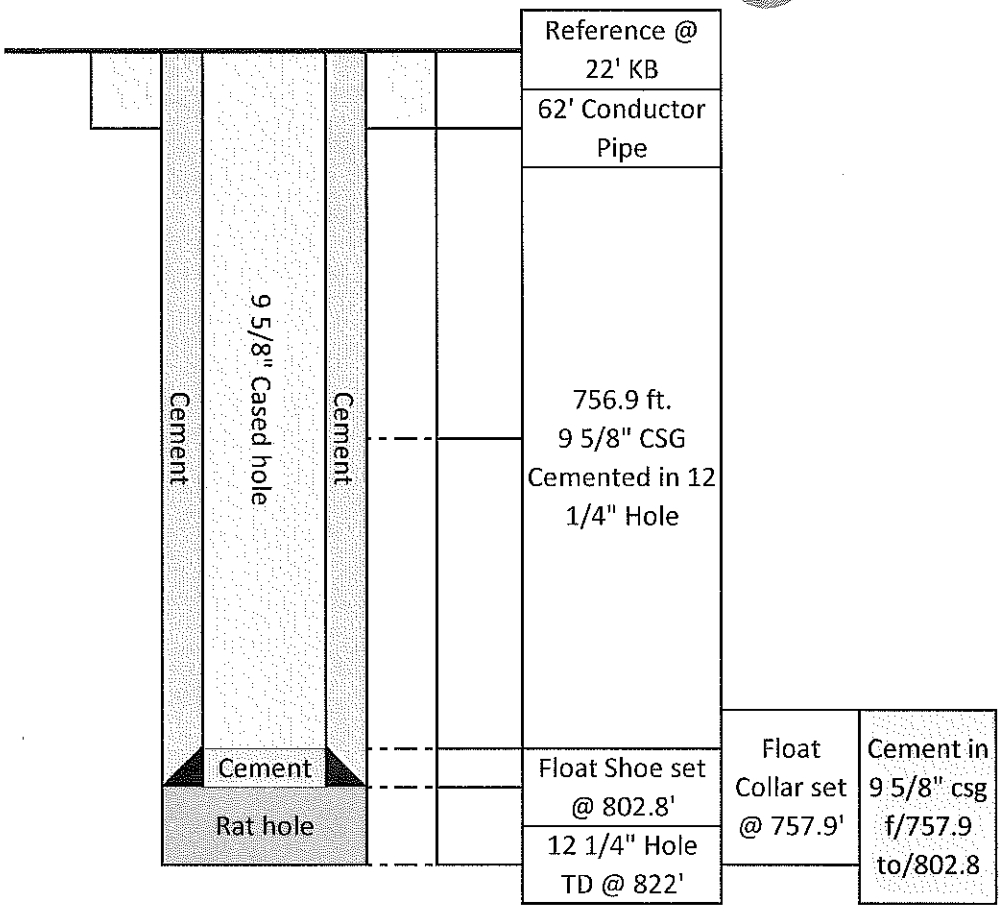

Well Name: Dixon Federal 12D-23-692 After P & A
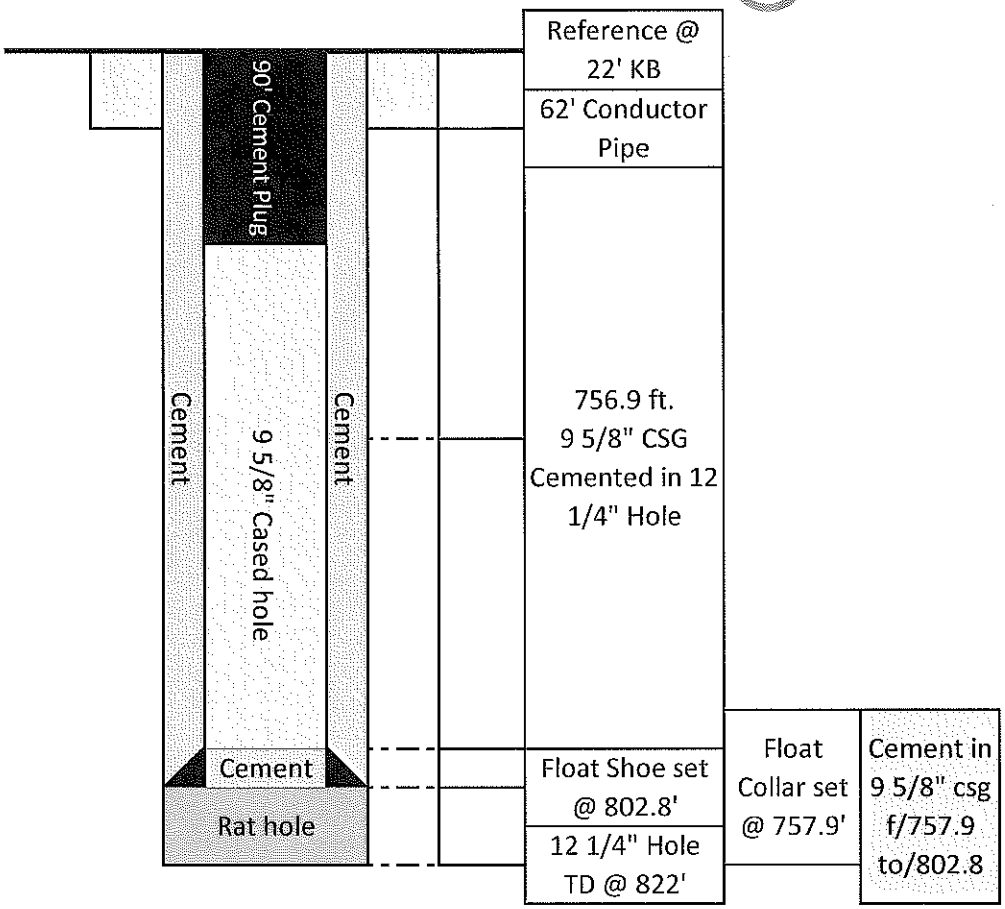
Bill Barrett Corporation