



01782830

# COLORADO WELL LOCATION

SECTION 2, TOWNSHIP 10 SOUTH, RANGE 56 WEST OF THE 6TH P M  
LINCOLN COUNTY, COLORADO

OPERATOR RUNNING FOXES PETROLEUM  
WELL NAME & NO JOHN CRAIG 11-2

RECEIVED

MAR 31 2009

COGCC

N89°48'56"W 5324 87'

CALCULATED POSITION


LATITUDE & LONGITUDE OF WELL (NAD83)

LATITUDE N 39 20617'  
LONGITUDE W 103 63322'

GROUND ELEVATION (NAVD88)  
5262

PDOP 1.9

SECTION 2

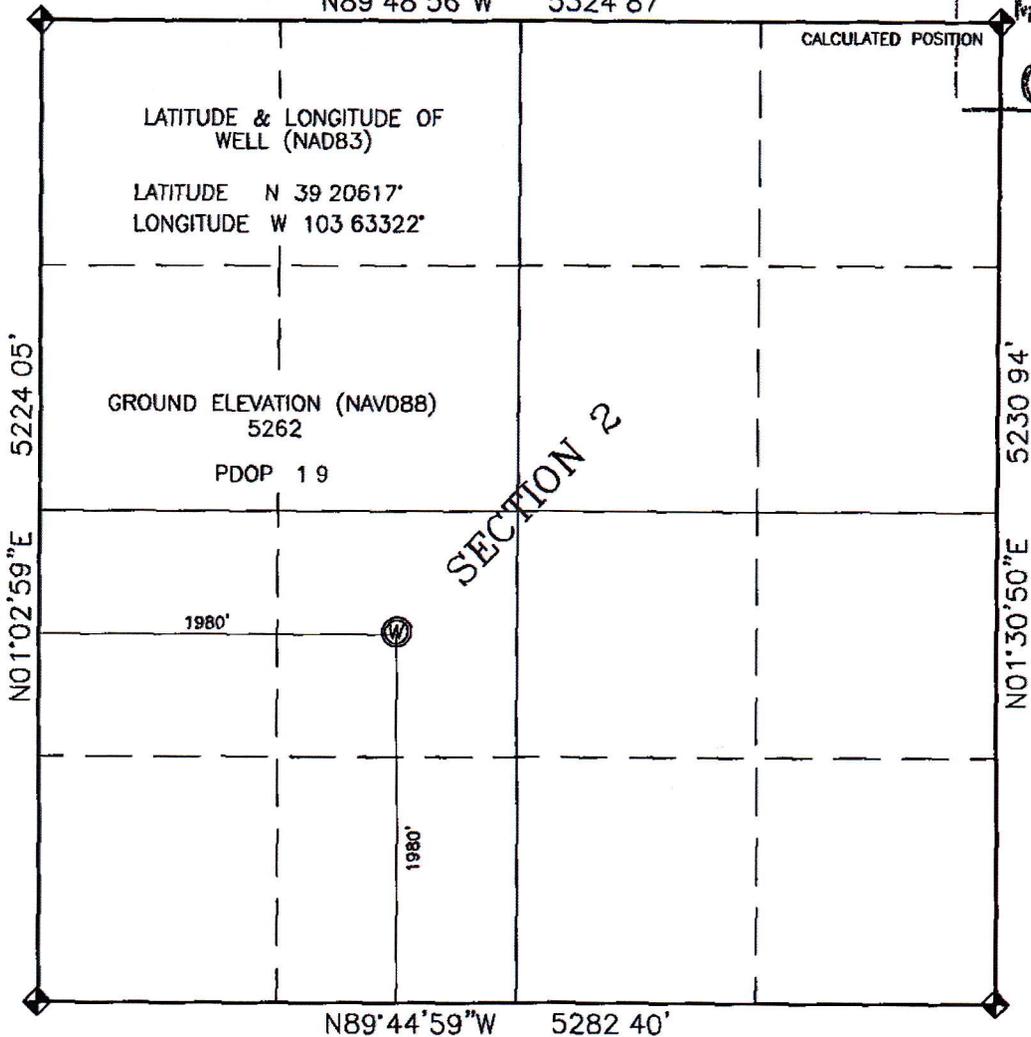

### GENERAL NOTES

- 1 BASIS OF BEARINGS FOR THIS EXHIBIT IS TRUE NORTH AS DETERMINED FROM GPS OBSERVATIONS AND REFERENCED AS SHOWN HEREON
- 2 ELEVATIONS SHOWN HEREON WERE DERIVED FROM POST PROCESSED GPS OBSERVATIONS AND ARE NAVD 88 DATUM
- 3 ALL DISTANCES AND BEARINGS ARE FIELD MEASURED
- 4 THE GROUND ELEVATION FOR THE WELL WAS MEASURED FROM THE BENCHMARK
- 5 DISTANCES TO WELLS ARE MEASURED AT 90° FROM SECTION LINES
- 6 THERE ARE NO IMPROVEMENTS WITHIN 200' OF WELL
- 7 SURFACE USE WITHIN 200' RADIUS OF WELL IS PASTURE

### LEGEND

- ◆ INDICATES ALU CAP SET AT SECTION CORNER LOCATION PLS 14142 (UNLESS NOTED OTHERWISE)
- ⊙ INDICATES LOCATION OF WELL

### SURVEYOR'S CERTIFICATE

I HEREBY CERTIFY THAT THIS WELL LOCATION CERTIFICATE WAS PREPARED BY ME OR UNDER MY DIRECT SUPERVISION THAT THE FIELD WORK WAS COMPLETED ON SEPTEMBER 30, 2008 FOR AND ON BEHALF OF RUNNING FOXES PETROLEUM THIS IS NOT A LAND SURVEY PLAT OR AN IMPROVEMENT SURVEY PLAT AND THAT IT IS NOT TO BE RELIED UPON FOR THE ESTABLISHMENT OF FUTURE BOUNDARIES, FENCE, BUILDING OR OTHER FUTURE IMPROVEMENTS

*Robert J. Rubino*  
ROBERT J RUBINO, PLS 14142

10/08/08  
DATE



RUBINO SURVEYING  
3312 AIRPORT ROAD  
BOULDER, CO 80301  
(303)464-9515 FAX (303)464-7792  
E-MAIL rubinosurveying@aol.com



Scale 1" = 1000 ft

NOTICE ACCORDING TO COLORADO LAW YOU MUST COMMENCE ANY LEGAL ACTION BASED UPON ANY DEFECT IN THIS SURVEY WITHIN THREE YEARS AFTER YOU FIRST DISCOVER SUCH DEFECT IN NO EVENT MAY ANY ACTION BASED UPON ANY DEFECT IN THIS SURVEY BE COMMENCED MORE THAN TEN YEARS FROM THE DATE OF CERTIFICATION SHOWN HEREON

DRAWN BY BR

APPROVED BY RJR

DATE OCTOBER 8, 2008

JOB NO 08153