



**Krabacher, Jay**


**To:** Neifert-Kraiser, Angela  
**Cc:** Andrews, David; Salazar, Sandi; Barber, Matt; Trahan, Kristin; King, Kevin  
**Subject:** RE: CBL deferment on the Jolley KP 324-9 (045-21202)

Angela:

WPX can delay the CBL on the subject well.

Regards,

Jay Krabacher

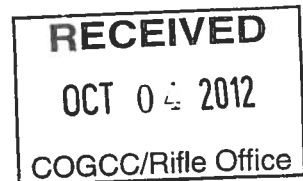

---

**From:** Neifert-Kraiser, Angela [<mailto:Angela.Neifert-Kraiser@wpxenergy.com>]  
**Sent:** Thursday, October 04, 2012 9:02 AM  
**To:** Krabacher, Jay; King, Kevin  
**Cc:** Andrews, David; Salazar, Sandi; Barber, Matt; Trahan, Kristin  
**Subject:** CBL deferment on the Jolley KP 324-9

Kevin, Dave, & Jay:

WPX Energy Rocky Mountain, LLC is requesting a CBL deferment on the Jolley KP 324-9 located in the NWNW Section 16, T6S-R91W. Attached is a temperature survey that was performed after cementing the 4 1/2" production casing on the subject well.


Information pertaining to the request is as follows:

Well:	Jolley KP 324-9
API:	05-045-21202-00
Location:	Section 16 T6S-R91W
Surface Csg:	9 5/8" set and cemented at 1425'
Production Csg Cement Date:	4 1/2" @ 7704' – cemented 10/01/12
Cement:	1190 sks
Cement top from survey:	3100' Estimated
Estimated top of gas:	4773' Estimated
Temp Survey:	10/01/12 Attached
Volume to fill annular:	Hole remained full following cementing operations

Please let me know if you need additional information to approve this deferment. After deferment is received, Williams will continue to monitor the bradenhead pressure until the CBL has been performed and notify if pressure exceeds 150 psig.

Angela Neifert-Kraiser  
Regulatory Specialist  
303-606-4398  
If You Are InSpired, You Can Do Anything!! :)

\*\*\*\*\*NOTE NEW EMAIL ADDRESS\*\*\*\*\*

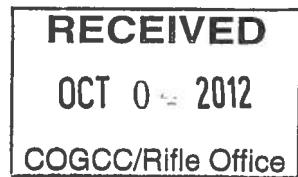

## Bradenhead Pressure Summary

WELL: Jolley KP 324-9

LOCATION: NW/4NW/4 SEC. 16 T6S-R91W 6<sup>TH</sup> PM

API#: 05-045-21202-00


TEMP. LOG RUN DATE: 10/01/2012

TOP OF CEMENT: 3100' (Est.)

TOP OF GAS: 4773' (Est.)

### BRADENHEAD PRESSURES (psig)


10/1/2012	09:30 6HR	0 BBLS	0 PSI
10/1/2012	15:30 12 HR	1 BBLS	0 PSI
10/2/2012	03:30 24 HR	4 BBLS	0 PSI
10/3/2012	03:30 48 HR	1 BBLS	0 PSI
10/4/2012	03:30 72 HR	0 BBLS	0 PSI

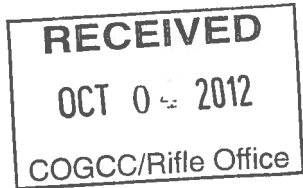

**WPX Energy Rocky Mountain Company, LLC  
Jolley KP 324-9  
Kokopelli Field**

**SHL 608' FNL 704' FWL (NW/4 NW/4) BHL 848' FSL 1994' FWL (SE/4 SW/4, Sec. 9, T6S, R91W)  
Section 16-T6S-R91W 6th PM  
Garfield County, Colorado**

**Formation Tops  
(Measured Depths)**

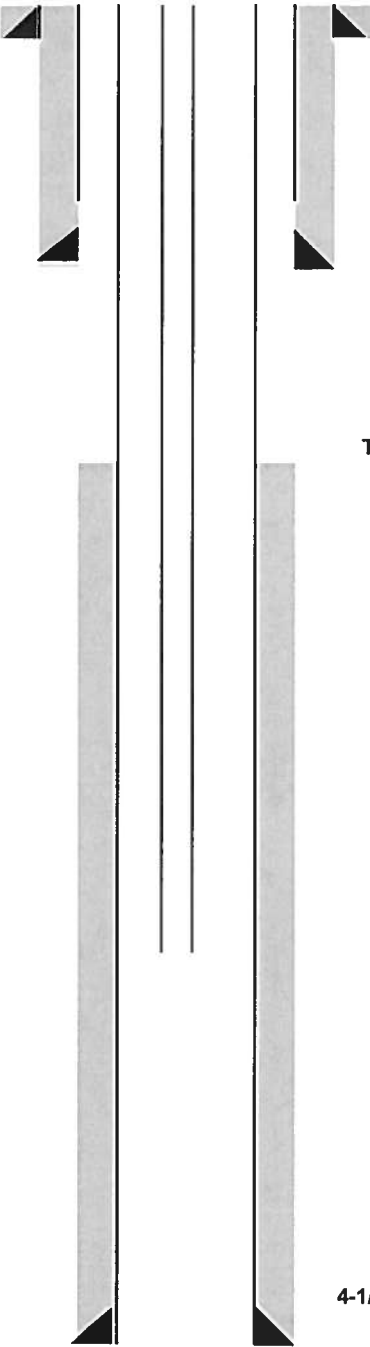

Conductor 24" Hole 16" casing/liner 60' w/44 sks cmt

Cmt @ Surface - (Cmt circ to surf during cmt job)

9 5/8" 32.3# ppf Csg. Set @1500'  
In 12 1/4" Hole W/395 Sks. Cmt

Mesaverde @ 3741' EST.

Cameo @ 7221' EST.

Rollins @ 7473' EST.

Top Of Cement 3100' EST.

Tubing String: 2-3/8" Set @

PBTD @  
TMD @ 7725'  
TVD @ 7176'

4-1/2", 11.6 ppf. Csg. Set @7704' W/1190 sks Cmt