




DRILLING COMPANY, INC.
WICHITA, KANSAS

Wellbore Diagram

Tagged cmt at 80' - topped off with 20 sx

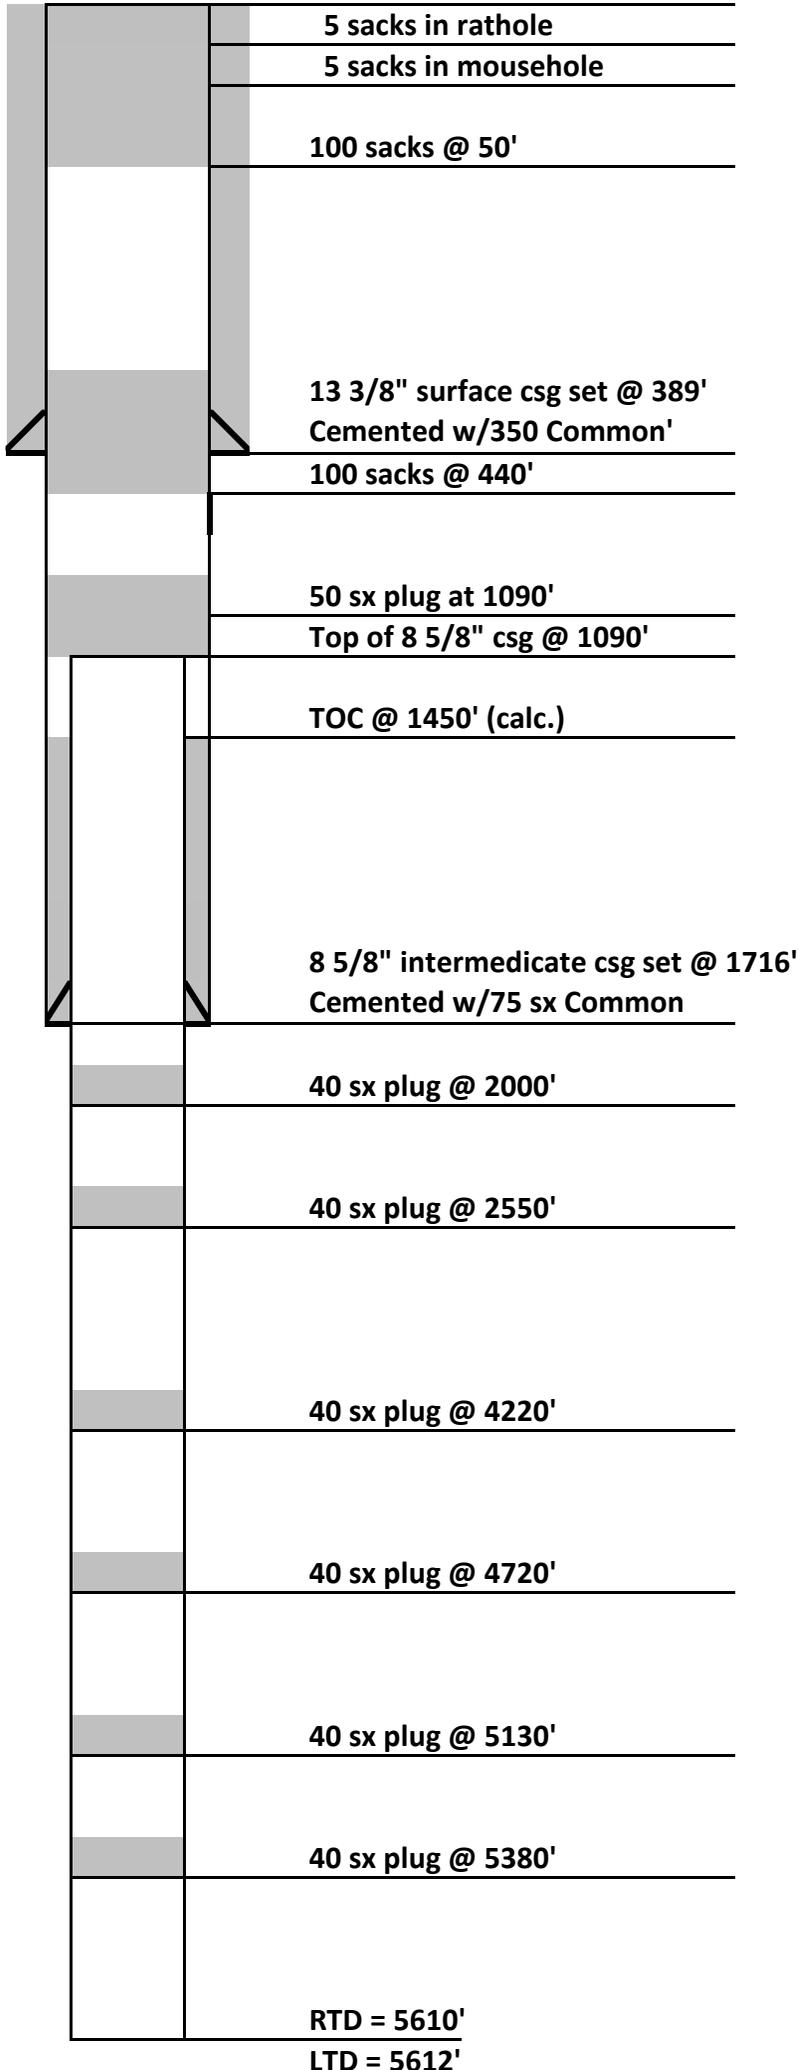

Date:	10/2/2012
Well Name:	Champlin-Figgins #3
Location:	1980' FSL & 660' FWL NW SW 27-13S-44W
County:	Cheyenne
State:	Colorado
API:	05-017-07721-00
Surface Casing:	13 3/8" set @ 389'
Cemented with:	350 sx Common
Intermediate Csg:	8 5/8" set @ 1716'
Cemented with:	75 sx Common
Total Depth:	5610'
Spud Date:	8/21/2012
P&A Date:	9/6/2012

<u>Log Tops:</u>	
Heebner Shale	4352
Lansing	4395
Marmaton	4762
Ft. Scott	4848
Cherokee Shale	4910
Atoka	5055
Morrow Shale	5183
Keys	5284
Mississippi	5340
RTD	5610
LTD	5612