Mountain Petroleum Corporation

Current Wellbore Diagram -- 10/1/2012

Smith-Whomble 1-3 API #05-125-06162-00

NESW Sec. 3-T2S-R43W

Yuma County, Colorado

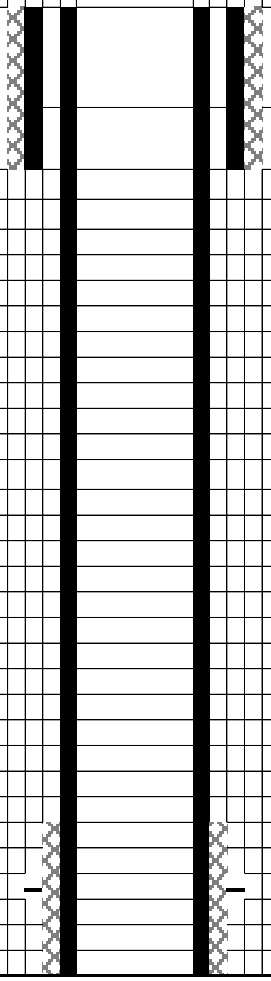

7" 23# Casing @160' (cemented to surface) . 1/12/1978

Casing leak below surface casing, location undetermined

Perfs: 1688'-1702' Niobrara (2/1/1978)

4 1/2" 9.5 # casing @ 1,820' 1/14/1978

TD 6 1/4" hole @ 1,860' MD