
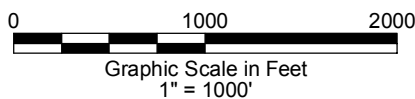


MULTI-WELL PLAN

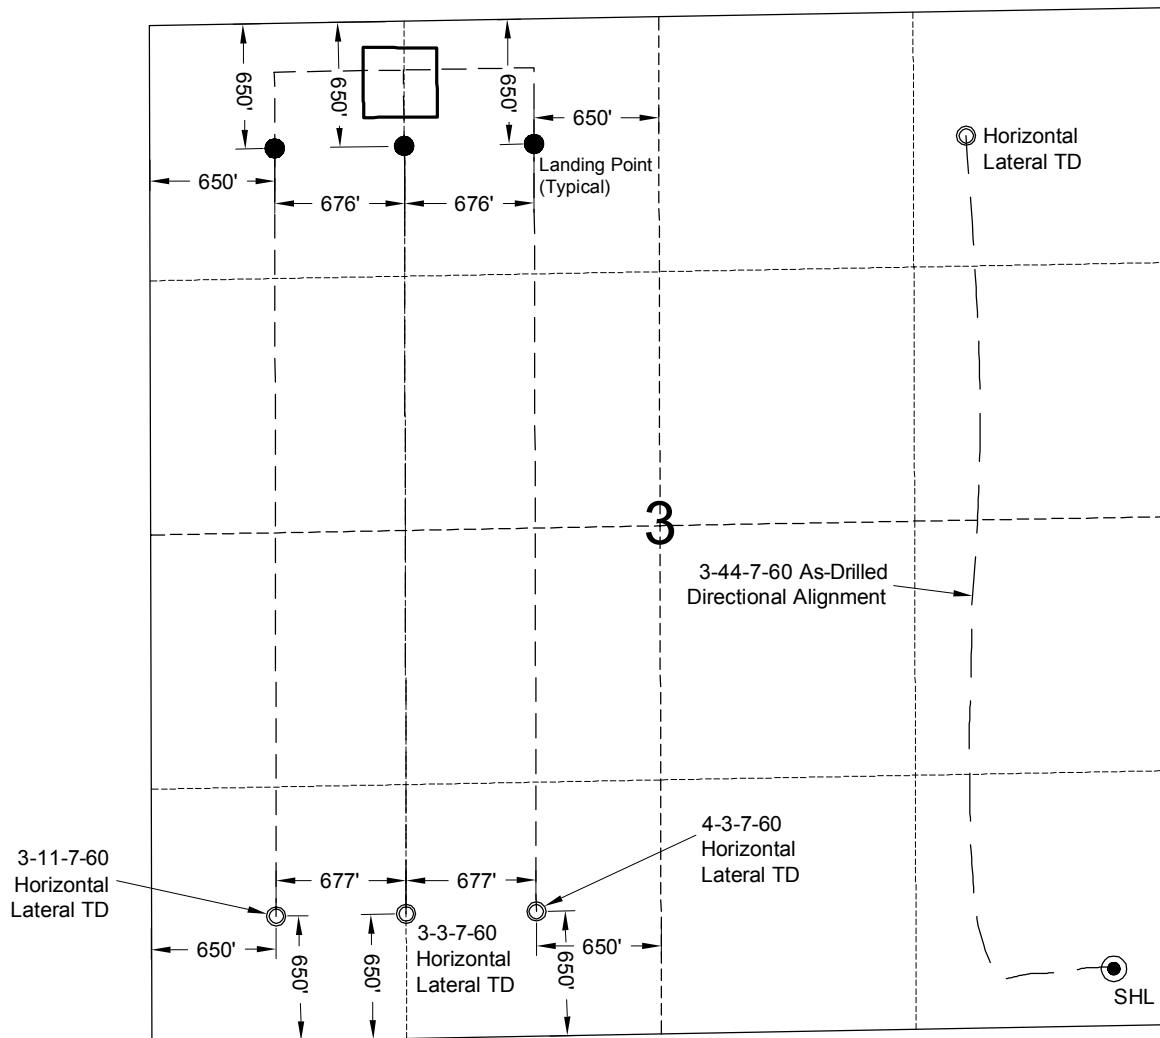

GEO SURV

LAND SURVEYING AND MAPPING
LAFAYETTE - WINTER PARK
Ph 303 666 0379 Fx 303 665 6320

CARRIZO OIL & GAS, INC
PERGAMOS 3-11-7-60 PAD

LOT 4 SECTION 3 T7N R60W
6th PM WELD COUNTY COLORADO

10/4/12