Well Name:	GGU Scott 11C-31-691	BILL BARRETT CORPORATION	
SHL:	SWSW Sec. 30 T6S R91W 6th PM	date updated	6/4/2012
		updated by	Megan Finnegan
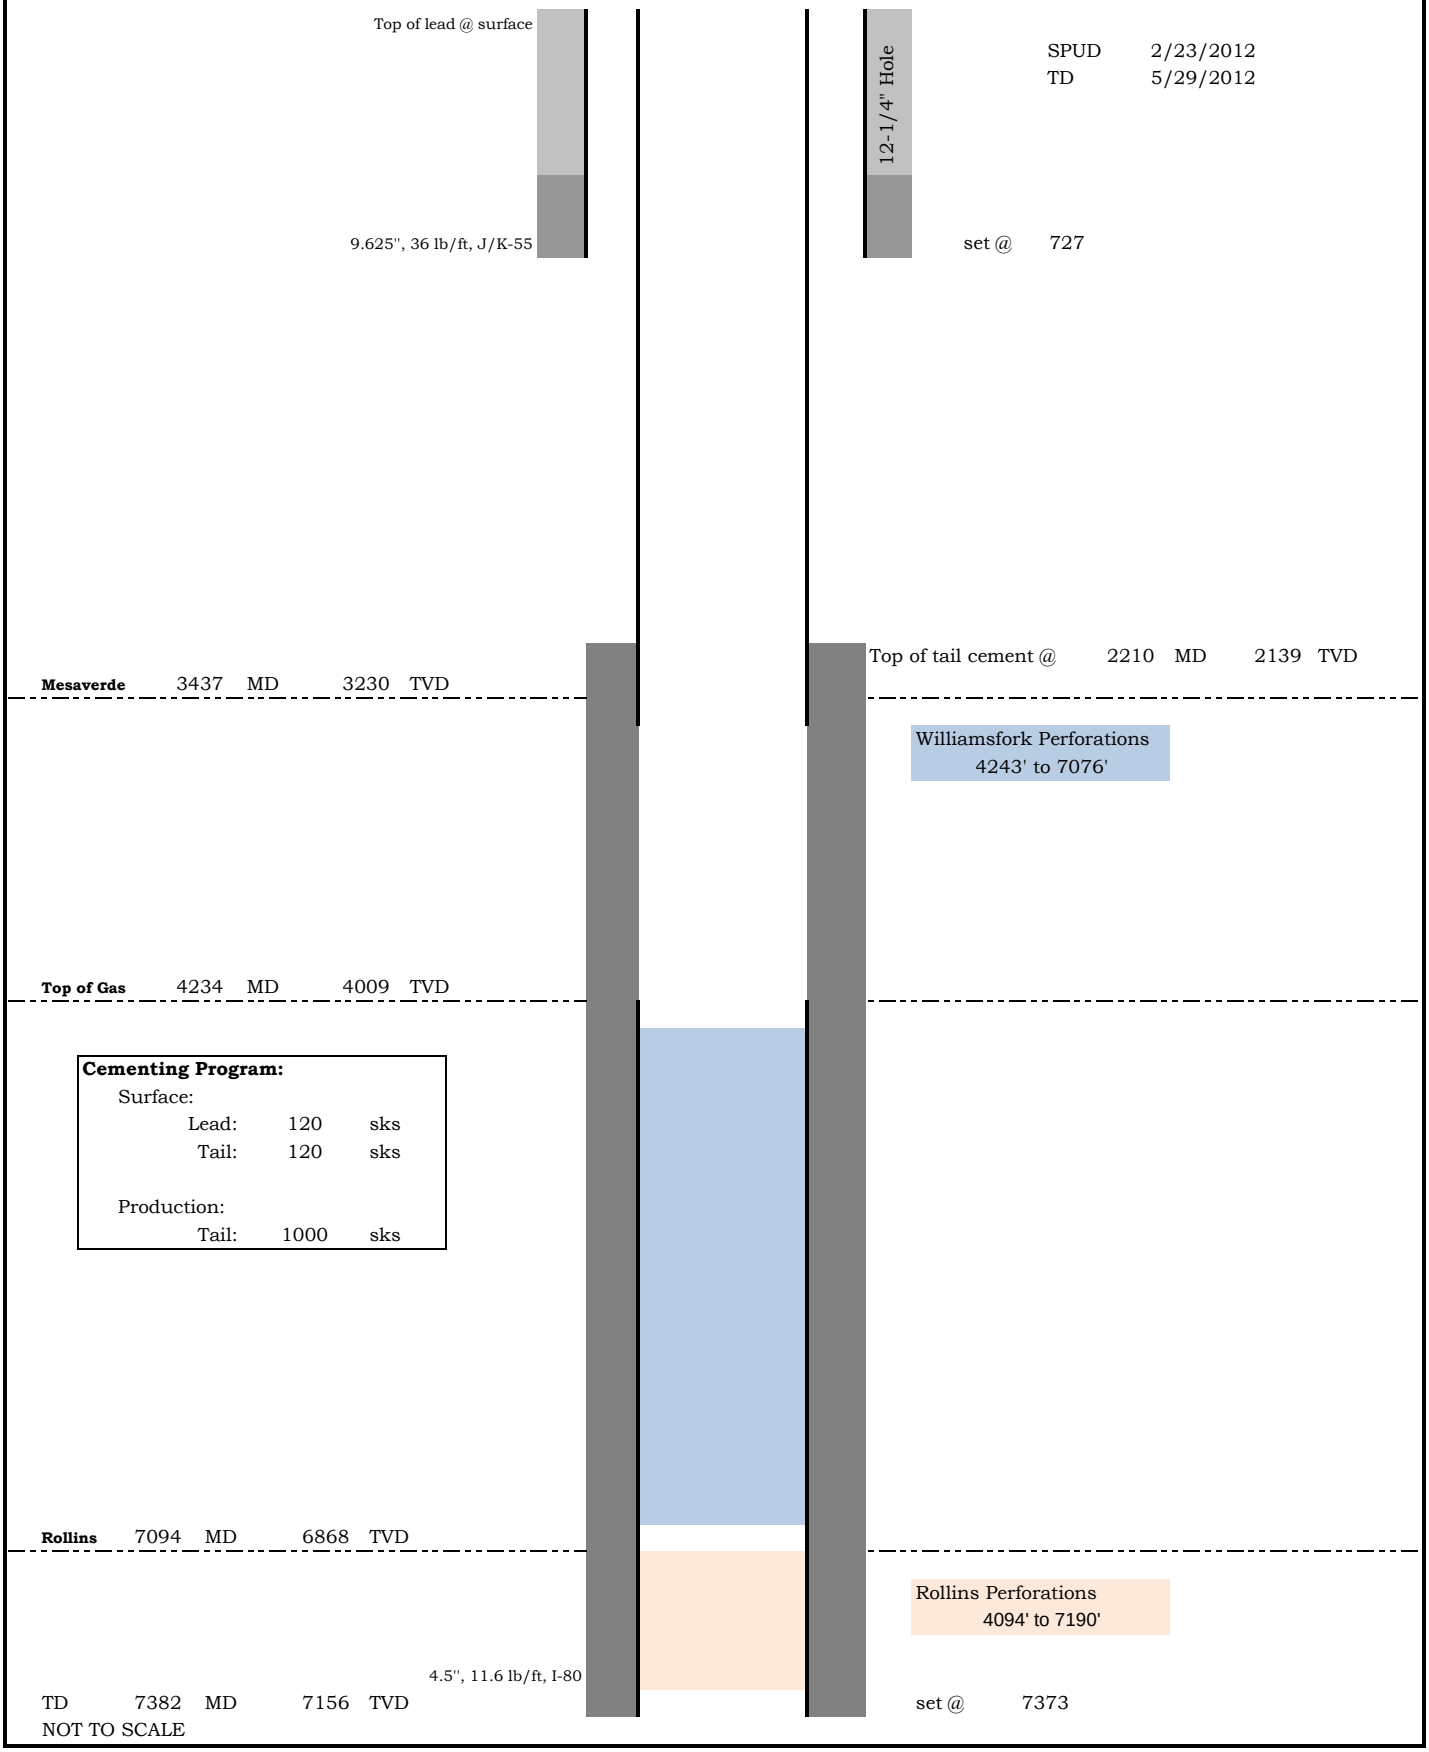
05-045-21253