




PDC Energy
 Magnussen 1-23
 SWSW 23 7N 66W 6 PM
 Weld County, CO
 Current Wellbore - NOT TO SCALE!!!
 10/5/2012

API#: 05-123-11293

GL Elevation: 4892

Surface Casing:
8 5/8" 24# @ 320' W/ 240 sks cmt.

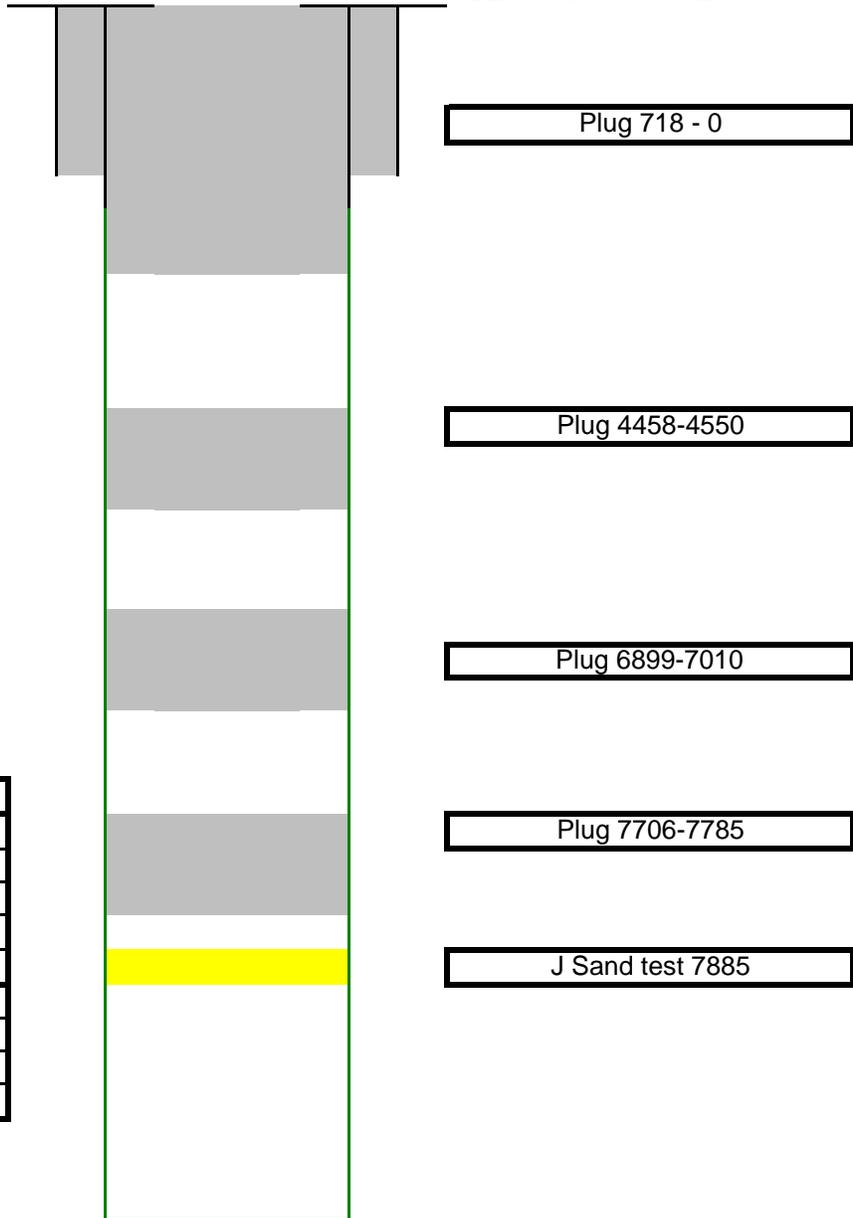

Perforations: none	
Old:	0
	0
	0
	0
New:	0
	0
	0
	0

NOTES

Re-entry to plug. Original plugging: 30 sx at 320', 10 sx at surface
 TIH w/ bit, tag 1st plug @ 4', drill to 98', tag 2nd plug @ 157', drill to 270, run bit to 518', circulate, TIH w/
 tubing, circ and condition hole to 7808', Run survey. TIH to 7785', pump 50 sx "G". Tag. plug. TIH to
 7010', pump 50 sx "G", tag plug. TIH to 4550', pump 70 sx "G". TIH to 718', pump 583 sx "G", circ 10 bbl
 to surface