


Well Name: LILLI UNIT 02-07

VERTICAL - ORIGINAL HOLE, 10/11/2012 9:11:16 AM

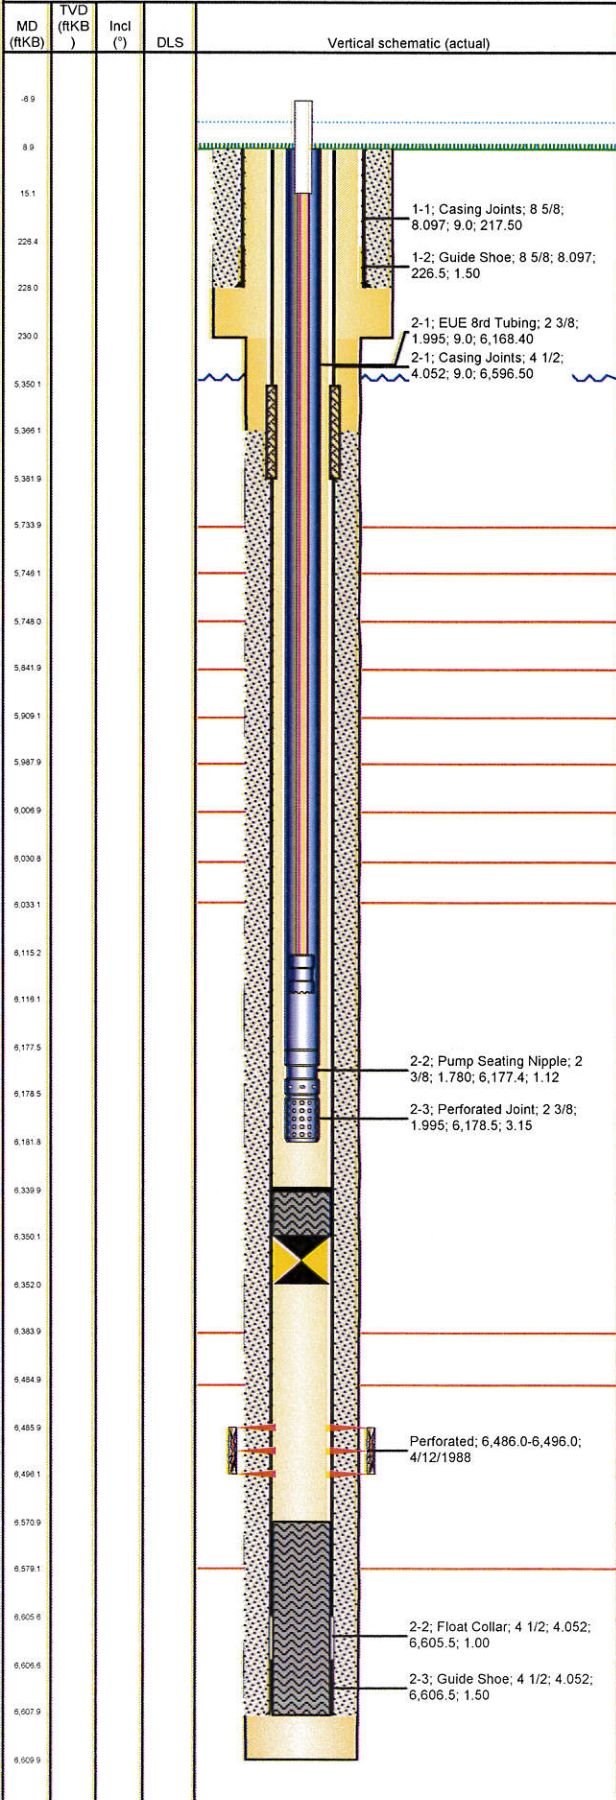

Well Header

| | | | |
|--|------------------------------|------------------------|-------------------------|
| API 05-123-13901 | Business Unit WATTENBERG | District 25 | Well Config VERTICAL |
| Original KB Elevation (ft) 4,807.00 | KB - GL / MSL (ftKB) 9.00 | Spud Date 3/31/1988 | P & A Date |

Comment

MINIMAL DATA AVAILABLE ON TUBING & RODS;
INFO ON 1/30/2003 FRAC NOT IN GREELEY FILE OR IN STATE DOCS

Directions To Well

HIWAY 14 AND WCR 129, NORTH 5.2 MILES (TO WCR 96), WEST 2.8 MILES
AND SOUTH 0.2 MILE INTO.

Surface Location (Congressional)

| | | | | | | | | |
|-----------|-----------|-----------|-----------|---------|----------|-----------|-------|------------|
| Quarter 1 | Quarter 2 | Quarter 3 | Quarter 4 | Section | Township | Twnshp... | Range | Rng E/W... |
| | | NW | NE | 7 | 8 | N | 58 | W |

Bottom Hole Location

| | | | |
|---------------------------|------------------|-------------------------|------------------|
| North-South Distance (ft) | From N or S Line | East-West Distance (ft) | From E or W Line |
| | | | |

Plug Back Total Depths

| Date | Depth (ftKB) | Method | Com |
|----------|--------------|----------------|---------------------------------------|
| 4/5/1988 | 6,605.5 | CASING TALLY | TOP OF FLOAT COLLAR |
| 4/8/1988 | 6,571.0 | CASED HOLE LOG | CBL DEPTH LOGGER |
| 9/6/2012 | 6,340.0 | TAG | SET CIBP @6350' PLUS 2 SXS CMT ON TOP |

Wellbore Sections

| Section Des | Size (in) | Act Top (ftKB) | Act Btm (ftKB) |
|-------------|-----------|----------------|----------------|
| SURFACE | 12 1/4 | 9.0 | 230.0 |
| PRODUCTION | 7 7/8 | 230.0 | 6,610.0 |

Zone Statuses

| Zone Name | Status Date | Status | Job |
|-----------|-------------|--------|---|
| D SAND | 5/3/1988 | PR | DRILLING/COMPLETION - ORIGINAL, 3/31/1988 00:00 |

Casing Strings

Surface, 228.0ftKB

| Casing Description | Run Date | OD (in) | Wt/Len (l...) | Grade | Top (ftKB) | Set Depth... |
|--------------------|-----------|---------|---------------|-------|------------|--------------|
| Surface | 3/31/1988 | 8 5/8 | 24.00 | K-55 | 9.0 | 228.0 |

Production, 6,608.0ftKB

| Casing Description | Run Date | OD (in) | Wt/Len (l...) | Grade | Top (ftKB) | Set Depth... |
|--------------------|----------|---------|---------------|-------|------------|--------------|
| Production | 4/5/1988 | 4 1/2 | 10.50 | K-55 | 9.0 | 6,608.0 |

Cement

| Description | Top Depth (ftKB) | Bottom Depth (ftKB) |
|--------------------------|------------------|---------------------|
| PRODUCTION CASING CEMENT | 5,366.0 | 6,608.0 |
| Description | Top Depth (ftKB) | Bottom Depth (ftKB) |
| SURFACE CASING CEMENT | 9.0 | 228.0 |
| Description | Top Depth (ftKB) | Bottom Depth (ftKB) |
| Cement Squeeze | 5,350.0 | 5,382.0 |
| Description | Top Depth (ftKB) | Bottom Depth (ftKB) |
| Dump Bail | 6,340.0 | 6,350.0 |

Tubing Components

| Item Des | OD (in) | Wt (lb/ft) | Grade | Jts | Len (ft) | Btm (ftKB) | Btm (TVD) (ftKB) |
|---------------------|---------|------------|-------|-----|----------|------------|---------------------|
| EUE 8rd Tubing | 2 3/8 | 4.70 | J-55 | 192 | 6,168.40 | 6,177.4 | |
| Pump Seating Nipple | 2 3/8 | 4.70 | J-55 | 1 | 1.12 | 6,178.5 | |
| Perforated Joint | 2 3/8 | 4.70 | J-55 | 1 | 3.15 | 6,181.7 | |

Rods & Pumps

| Rod Description | Run Date | Set Depth (ftKB) |
|-----------------|----------|------------------|
| Rod | 9/6/2012 | 6,116.0 |
| Comment | | |


| Item Description | OD Nominal (in) | Joints | Length (ft) |
|------------------|-----------------|--------|-------------|
| Polished Rod | 1 1/4 | 1 | 22.00 |
| Item Description | OD Nominal (in) | Joints | Length (ft) |
| Sucker Rod | 3/4 | 244 | 6,100.00 |
| Item Description | OD Nominal (in) | Joints | Length (ft) |
| No-Go | 1.78 | 1 | 1.00 |

Perforation Data

| Zone | Bnch/St g | Entered Shot Total | Top (ftKB) | Btm (ftKB) | Date |
|-----------------------|--------------|-----------------------|------------|------------|-----------|
| D SAND, ORIGINAL HOLE | | 41 | 6,486.0 | 6,496.0 | 4/12/1988 |

Well Name: LILLI UNIT 02-07

VERTICAL - ORIGINAL HOLE, 10/11/2012 9:11:16 AM

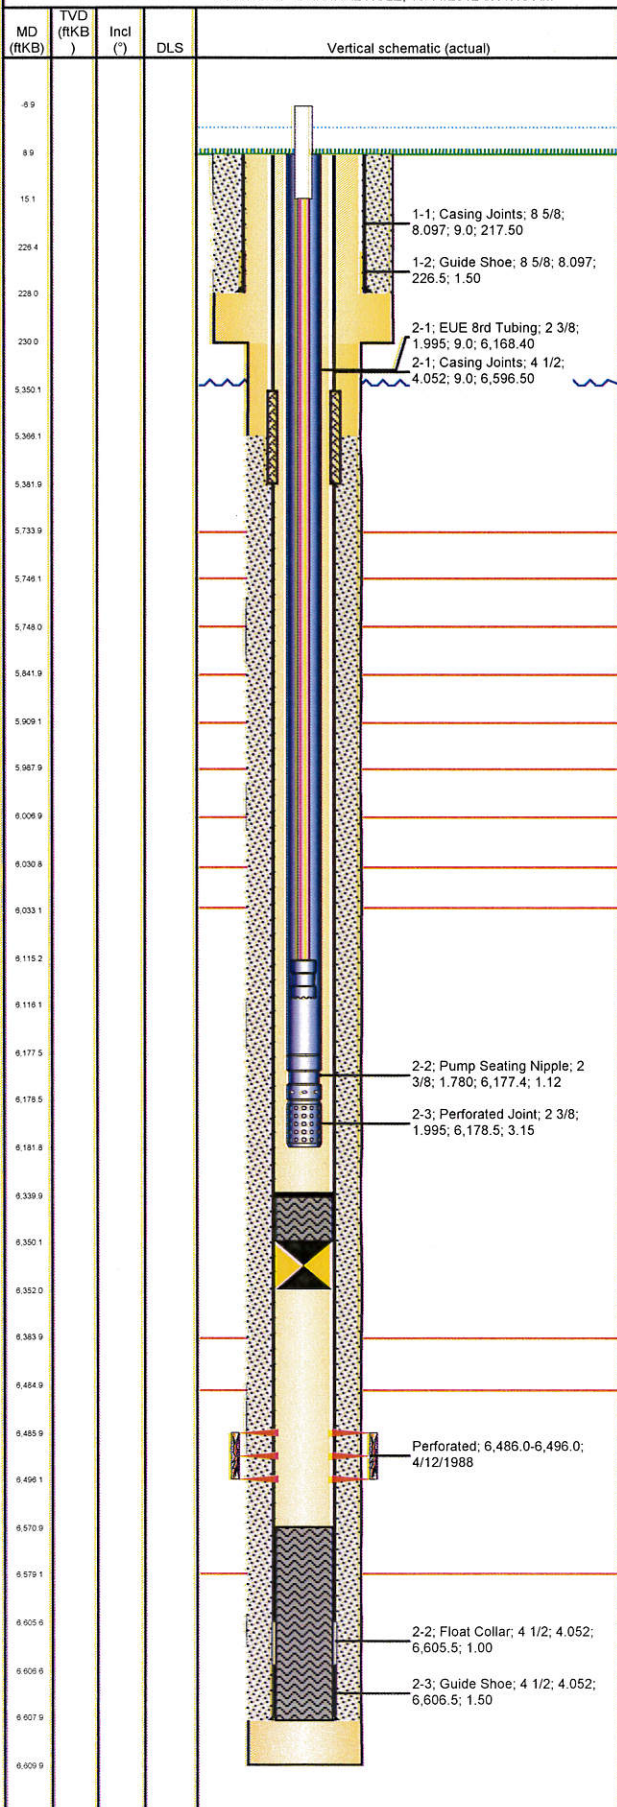

Stimulations & Treatments

| | | |
|------------------|-----------------------|--------------------------------|
| Date | Zone | Primary Job Type |
| 4/15/1988 | D SAND, ORIGINAL HOLE | DRILLING/COMPLETION - ORIGINAL |
| Technical Result | Tech Result Details | Tech Result Note |
| | | |
| Comment | | |

Other In Hole

| Run Date | Des | OD (in) | Top (ftKB) | Btm (ftKB) |
|----------|-----------------------|---------|------------|------------|
| 9/6/2012 | Cast Iron Bridge Plug | 4 | 6,350.0 | 6,352.0 |

Logs

| Date | Type | Top (ftKB) | Btm (ftKB) |
|----------|---------------------|------------|------------|
| 4/6/1988 | COMPENSATED DENSITY | 6,430.0 | 6,600.0 |
| 4/6/1988 | INDUCTION | 228.0 | 6,597.0 |
| 4/6/1988 | MICROLOG | 6,020.0 | 6,560.0 |
| 4/8/1988 | CBL/CCL/GR | 5,275.0 | 6,565.0 |