


GL: 8109'
KB: 8125'
Updated: 04/13/09 PJD
0-5deg. inclination @ 0-2023'

Spudded: 5/12/08
Stimulation Finished:

SGU CP07C-27 L27 496
ConocoPhillips
Piceance Basin
Garfield County, CO
API: 0504515030

5-27 deg. inclination @ 2023'-8325'

0-5 deg. inclination @ 8325'-TD

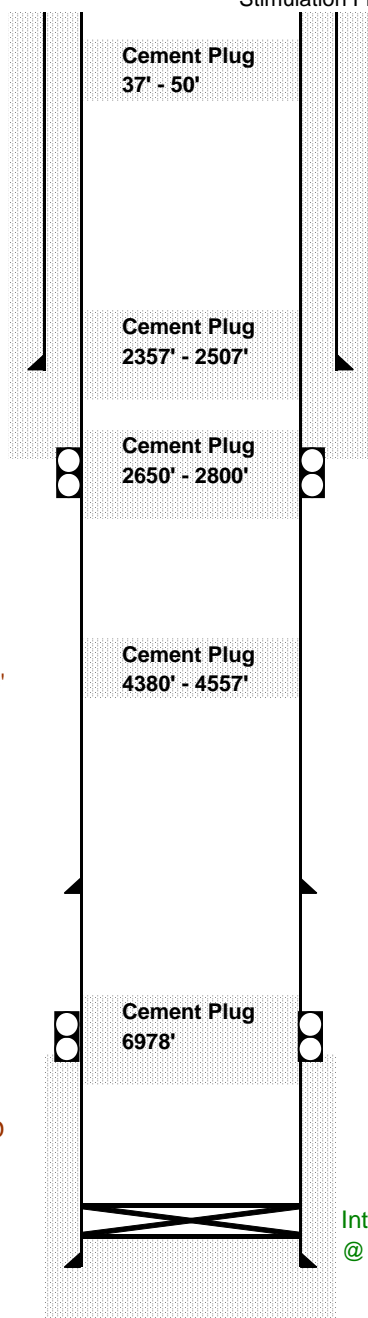

Sfc Csg: 9.625" x 8.835" OD 36# J-55
@ 2430' KB

Squeeze Perfs @ 2700' KB

Stage Collar @ 5992' KB

TOC @ 7030'
Squeeze Perfs @ 7030' KB

Cement Retainer @ 8308' KB
Int. Csg: 7.0" x 6.276" 26# / 6.366" 23# N-80
@ 8399' KB
Float Collar @ 8352' KB
Float Shoe @ 8399' KB

Marker jts: Tops @ 492' (37.49')
@ 1207' (38.74')
@ 2343' (37.60')
@ 2550' (39.13')
@ 2801' (38.08')
@ 2967' (38.04')
@ 3302' (38.00')
@ 4141' (38.01')
@ 4179' (39.20')
@ 5151' (39.31')