| Well Name: | Scott 41C-36-692 | BILL BARRETT CORPORATION |
|---|---|---|
| SHL: | SWSW Sec. 30 T6S R91W 6th PM | date updated 10/10/2012 |
| | | updated by Megan Finnegan |
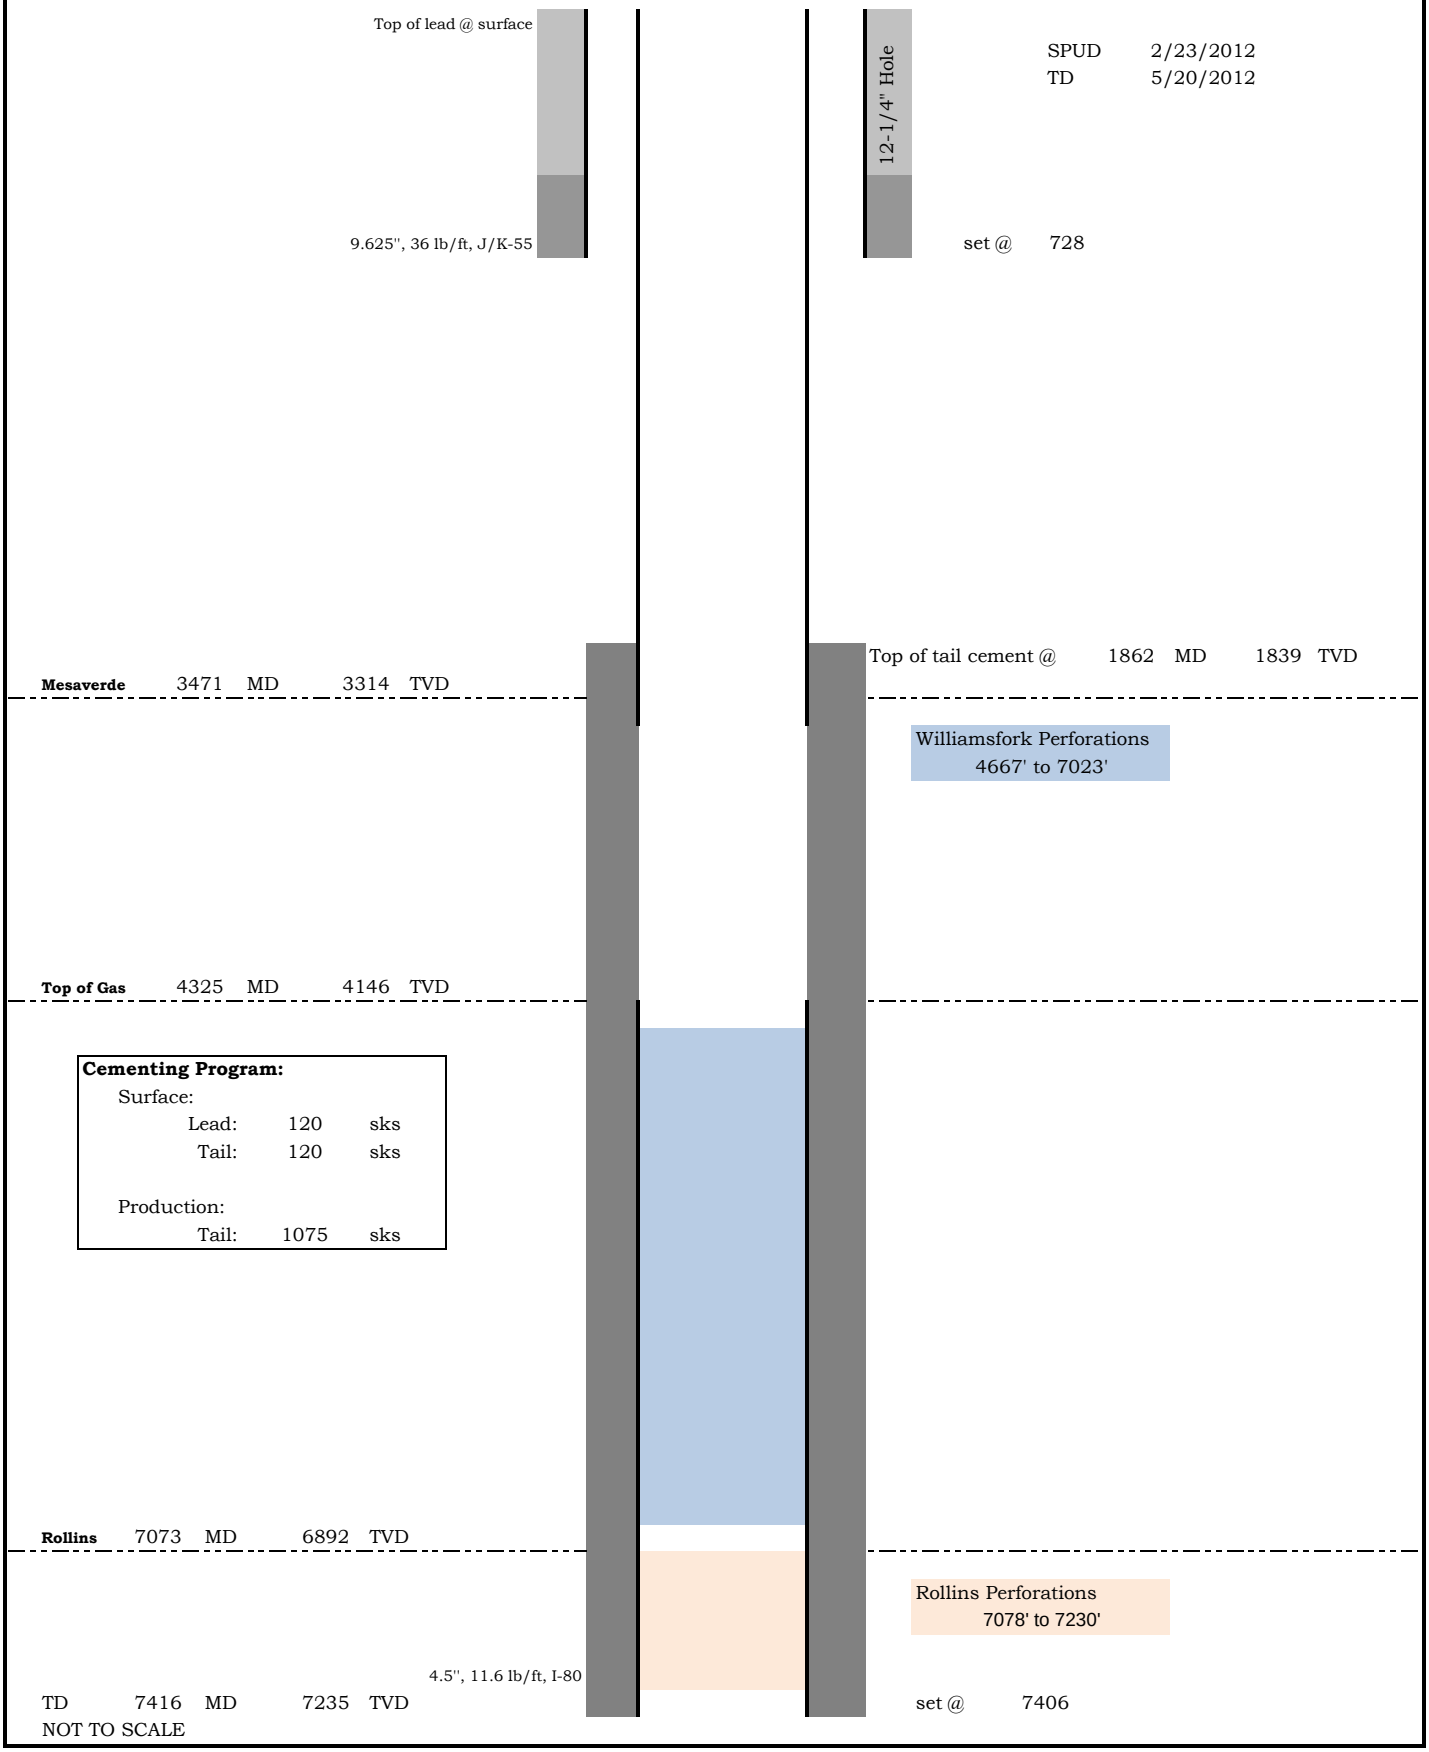
05-045-21248