Well Name:	Scott 44A-25-692	BILL BARRETT CORPORATION
SHL:	SWSW Sec. 30 T6S R91W 6th PM	date updated 10/10/2012
		updated by Megan Finnegan
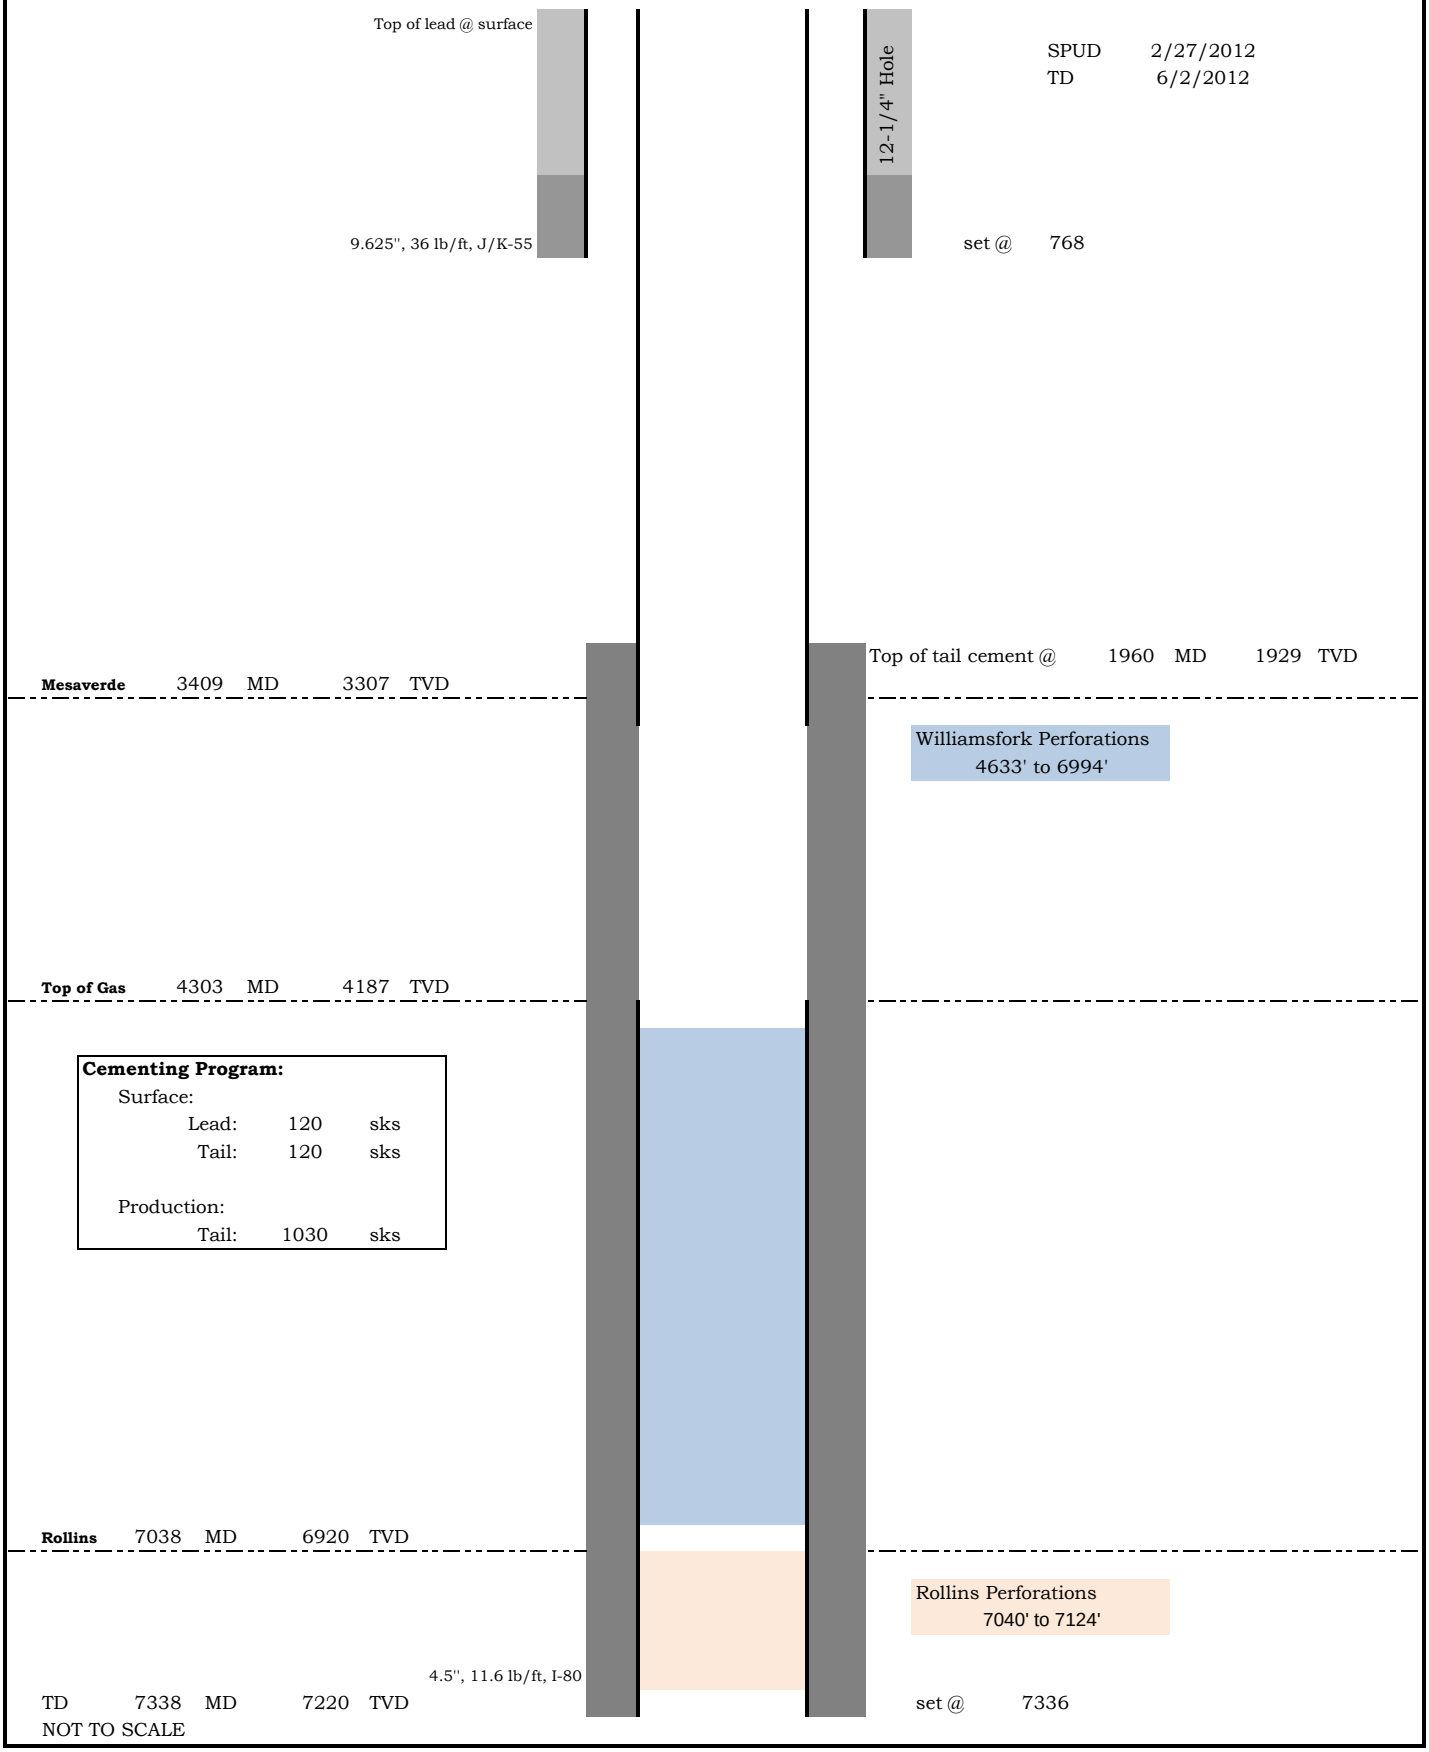
05-045-21258