




DRILLING COMPANY, INC.
WICHITA, KANSAS

Wellbore Diagram

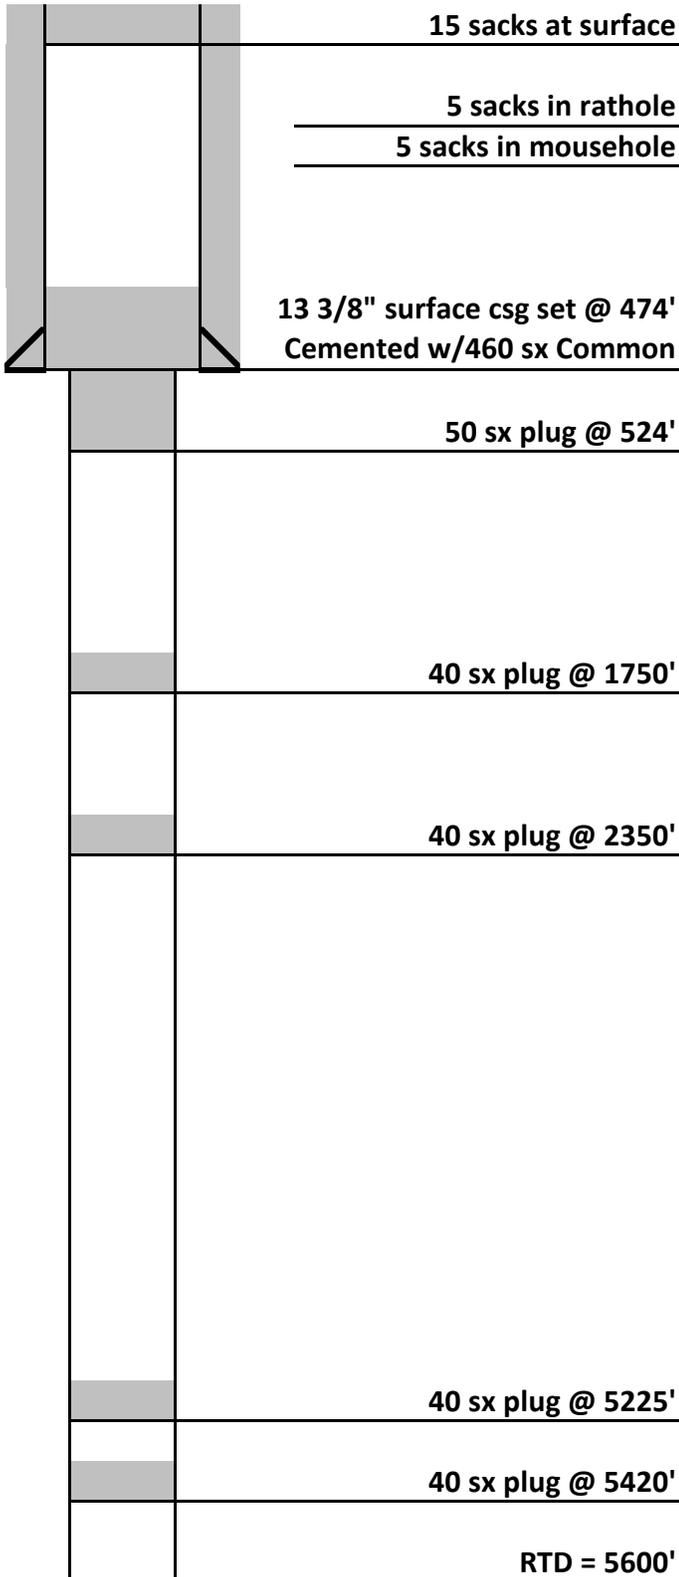

Date:	<u>10/15/2012</u>
Well Name:	<u>Hoffman-Busby #1-24</u>
Location:	<u>1050' FNL & 660' FEL</u> <u>SE/4 NE/4 24-14S-45W</u>
County:	<u>Cheyenne</u>
State:	<u>Colorado</u>
API:	<u>05-017-07720-00</u>
Surface Casing:	<u>13 3/8" set @ 474'</u>
Cemented with:	<u>460 sx Common</u>
Total Depth:	<u>5600'</u>
Spud Date:	<u>9/7/2012</u>
P&A Date:	<u>9/21/2012</u>

<u>LOG TOPS</u>	<u>FORMATION</u>	<u>DEPTH</u>
	Shawnee	4143
	Heebner Shale	4327
	Lansing	4363
	Marmaton	4742
	Ft. Scott	4811
	Cherokee Shale	4878
	Atoka Shale	5012
	Morrow Shale	5144
	Keyes	5261
	Mississippian	5304