

WPX Energy Rocky Mtn LLC

FINAL

**RWF 421-32**


API #05-045-21051-00

1076' FNL x 1352' FWL - SHL

418' FNL x 1843' FWL - BHL

(NENW) Sec. 32-T6S-R94W

Garfield County, Colorado

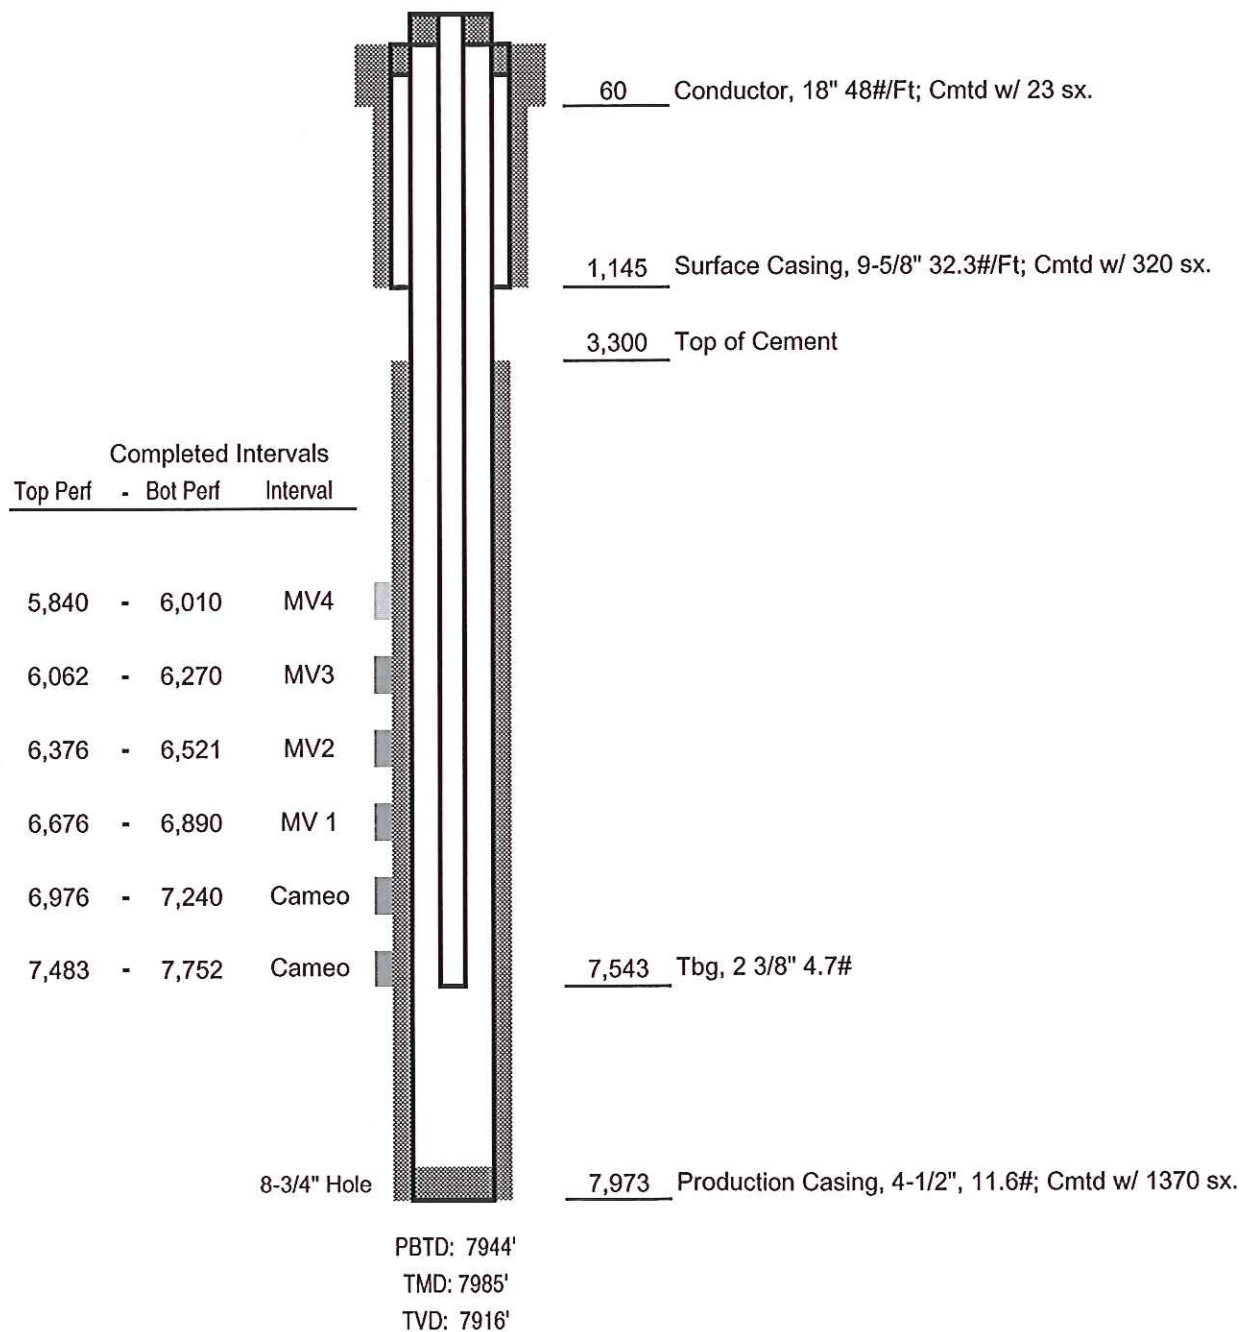

Not to Scale