


# Wellbore Schematic Input Report

Well Name: SINJIN E36-16

VERTICAL - ORIGINAL HOLE, 10/19/2012 9:36:00 AM

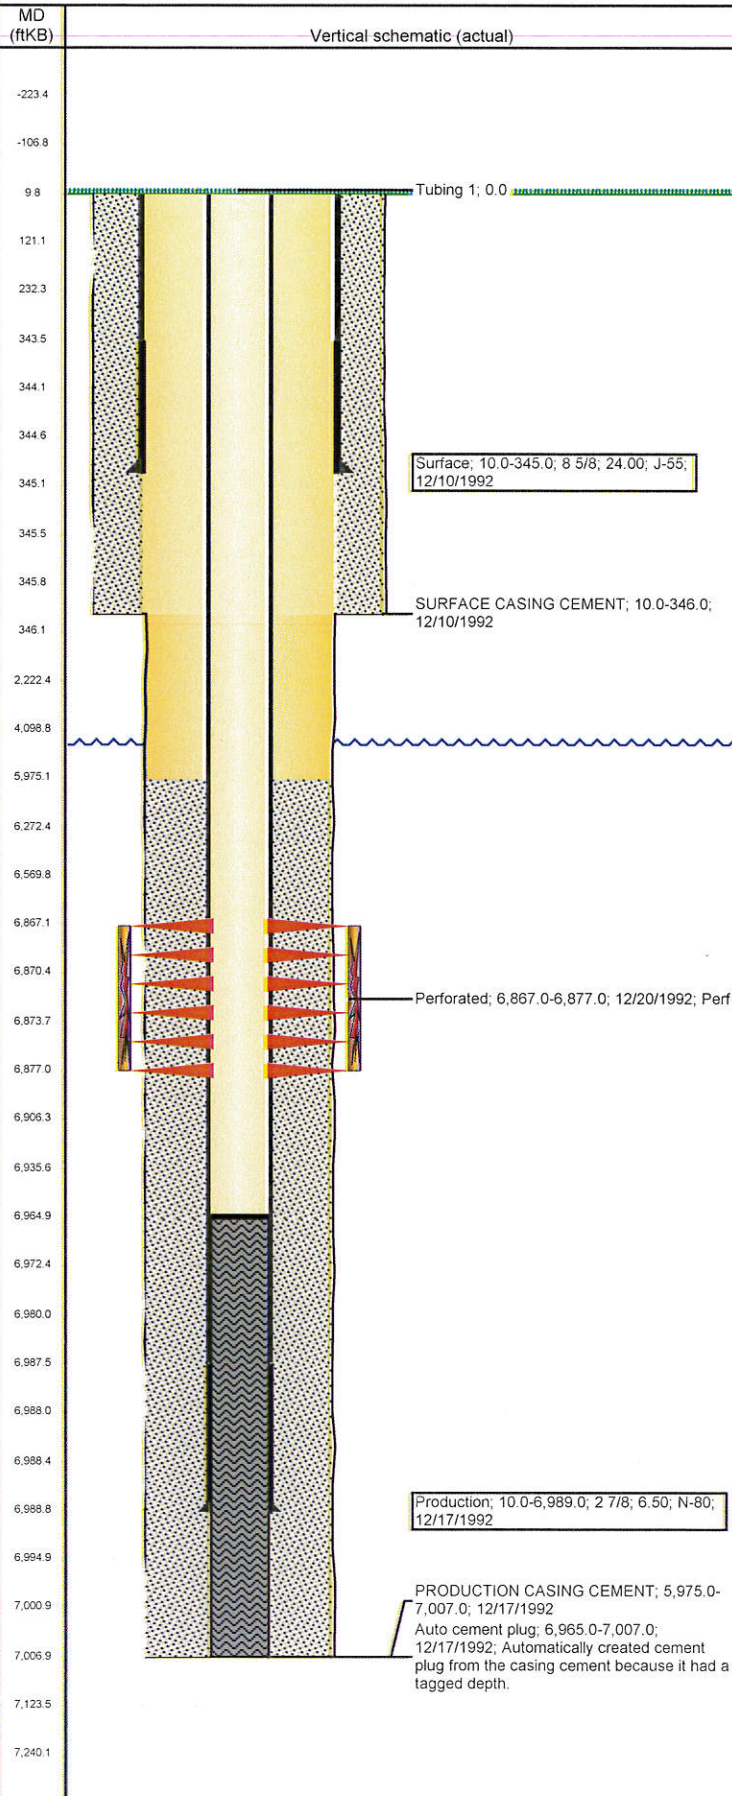

## Well Header

API	Business Unit	District	Well Config
05-123-16469	WATTENBERG	15	VERTICAL
Original KB Elevation (ft)	KB - GL / MSL (ftKB)	Spud Date	P & A Date
4,650.00	10.00	12/10/1992	
Comment			
Frac'd into by Prima 2/00			
Directions To Well			

## Congressional Location

Quarter 1	Quarter 2	Quarter 3	Quarter 4	Section	Township	Twnshp N...	Range	Rng E/W Dir
		SE	SE	36	6	N	65	W

## Bottom Hole Location

North-South Distance (ft)	From N or S Line	East-West Distance (ft)	From E or W Line
---------------------------	------------------	-------------------------	------------------

## Plug Back Total Depths

Date	Depth (ftKB)	Method	Com
12/17/1992	6,965.0	TAG	

## Wellbore Sections

Section Des	Size (in)	Act Top (ftKB)	Act Btm (ftKB)
SURFACE	12 1/4	10.0	346.0
PRODUCTION	7 7/8	346.0	7,007.0

## Zone Statuses

Zone Name	Status Date	Status	Job
CODELL	2/10/1993	PR	DRILLING/COMPLETION - ORIGINAL, 12/10/1992 00:00

## Casing Strings

### Surface, 345.0ftKB

Casing Description	Run Date	OD (in)	Wt/Len (l...)	Grade	Top (ftKB)	Set Depth...
Surface	12/10/1992	8 5/8	24.00	J-55	10.0	345.0

### Production, 6,989.0ftKB

Casing Description	Run Date	OD (in)	Wt/Len (l...)	Grade	Top (ftKB)	Set Depth...
Production	12/17/1992	2 7/8	6.50	N-80	10.0	6,989.0

## Cement

Description	Top Depth (ftKB)	Bottom Depth (ftKB)
SURFACE CASING CEMENT	10.0	346.0
Description	Top Depth (ftKB)	Bottom Depth (ftKB)
PRODUCTION CASING CEMENT	5,975.0	7,007.0

## Tubing Components

Item Des	OD (in)	Wt (lb/ft)	Grade	Jts	Len (ft)	Btm (ftKB)	Btm (TVD) (ftKB)
						0.0	

## Perforation Data

Zone	Bnch/St g	Entered Shot Total	Top (ftKB)	Btm (ftKB)	Date
CODELL, ORIGINAL HOLE		40	6,867.0	6,877.0	12/20/1992

## Stimulations & Treatments

Date	Zone	Primary Job Type
12/21/1992	CODELL, ORIGINAL HOLE	DRILLING/COMPLETION - ORIGINAL
Technical Result	Tech Result Details	Tech Result Note

Comment

## Other In Hole

Run Date	Des	OD (in)	Top (ftKB)	Btm (ftKB)
----------	-----	---------	------------	------------

## Logs

Date	Type	Top (ftKB)	Btm (ftKB)
12/17/1992	COMPENSATED DENSITY	3,400.0	7,007.0
12/17/1992	INDUCTION	3,400.0	4,500.0
12/20/1992	CEMENT BOND	5,770.0	4,500.0