




Lease Name: Margil 34PD

Legals: SWSE – Sec. 34, T4N, R68W

County: Weld County, Colorado

API#: 05-123-35152

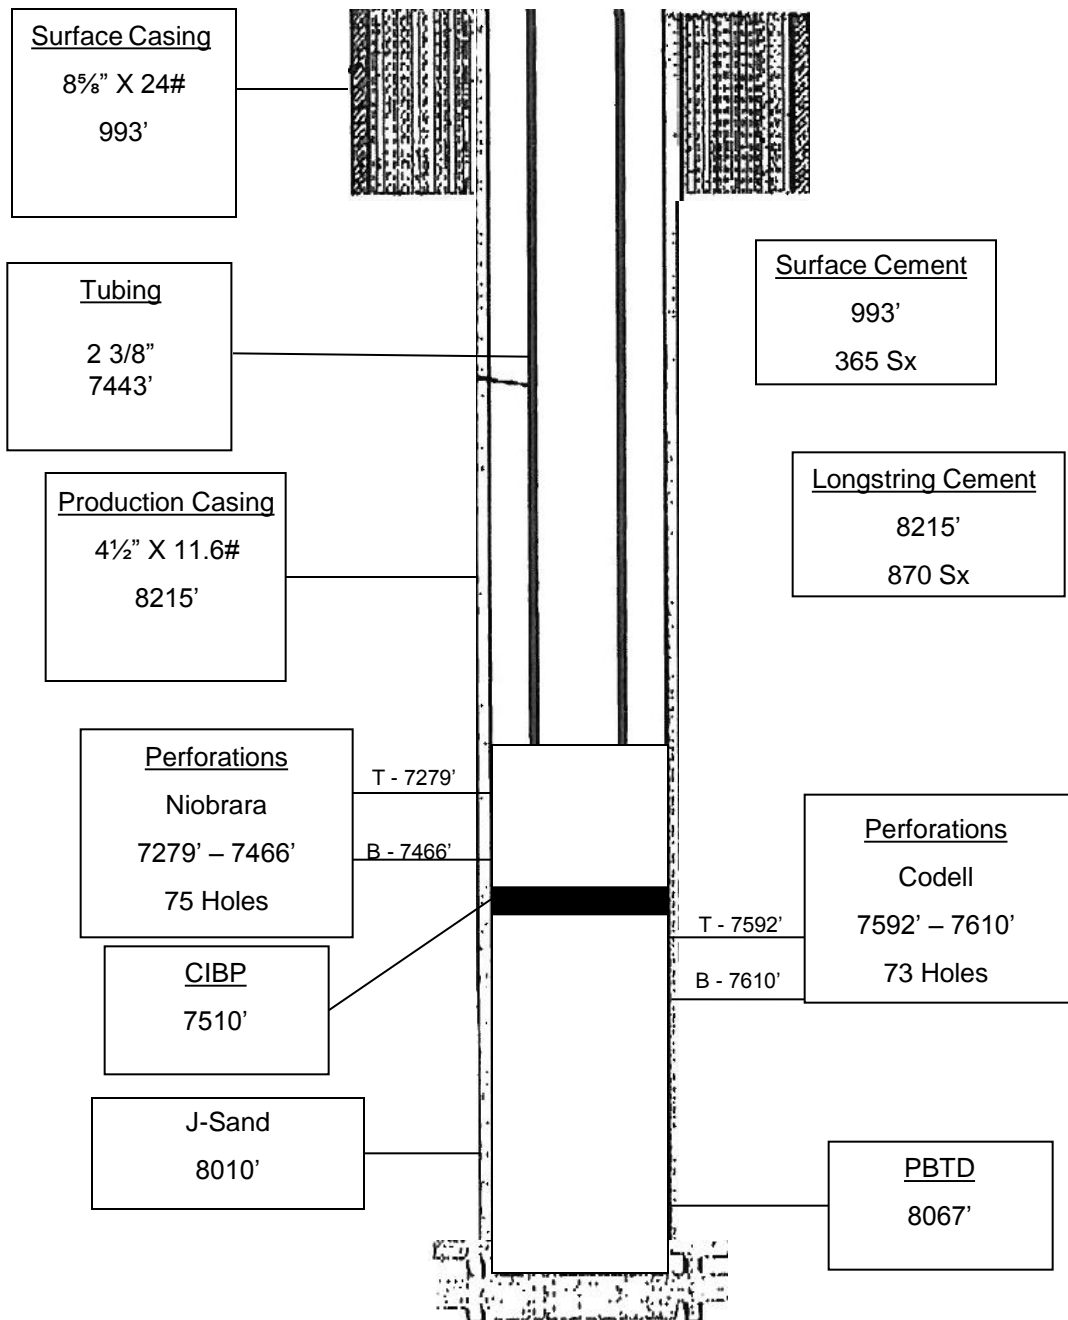

Wellbore Diagram