




**Lease Name:** Margil 43-34D

**Legals:** SESE – Sec. 34, T4N, R68W

**County:** Weld County, Colorado

**API#:** 05-123-35164

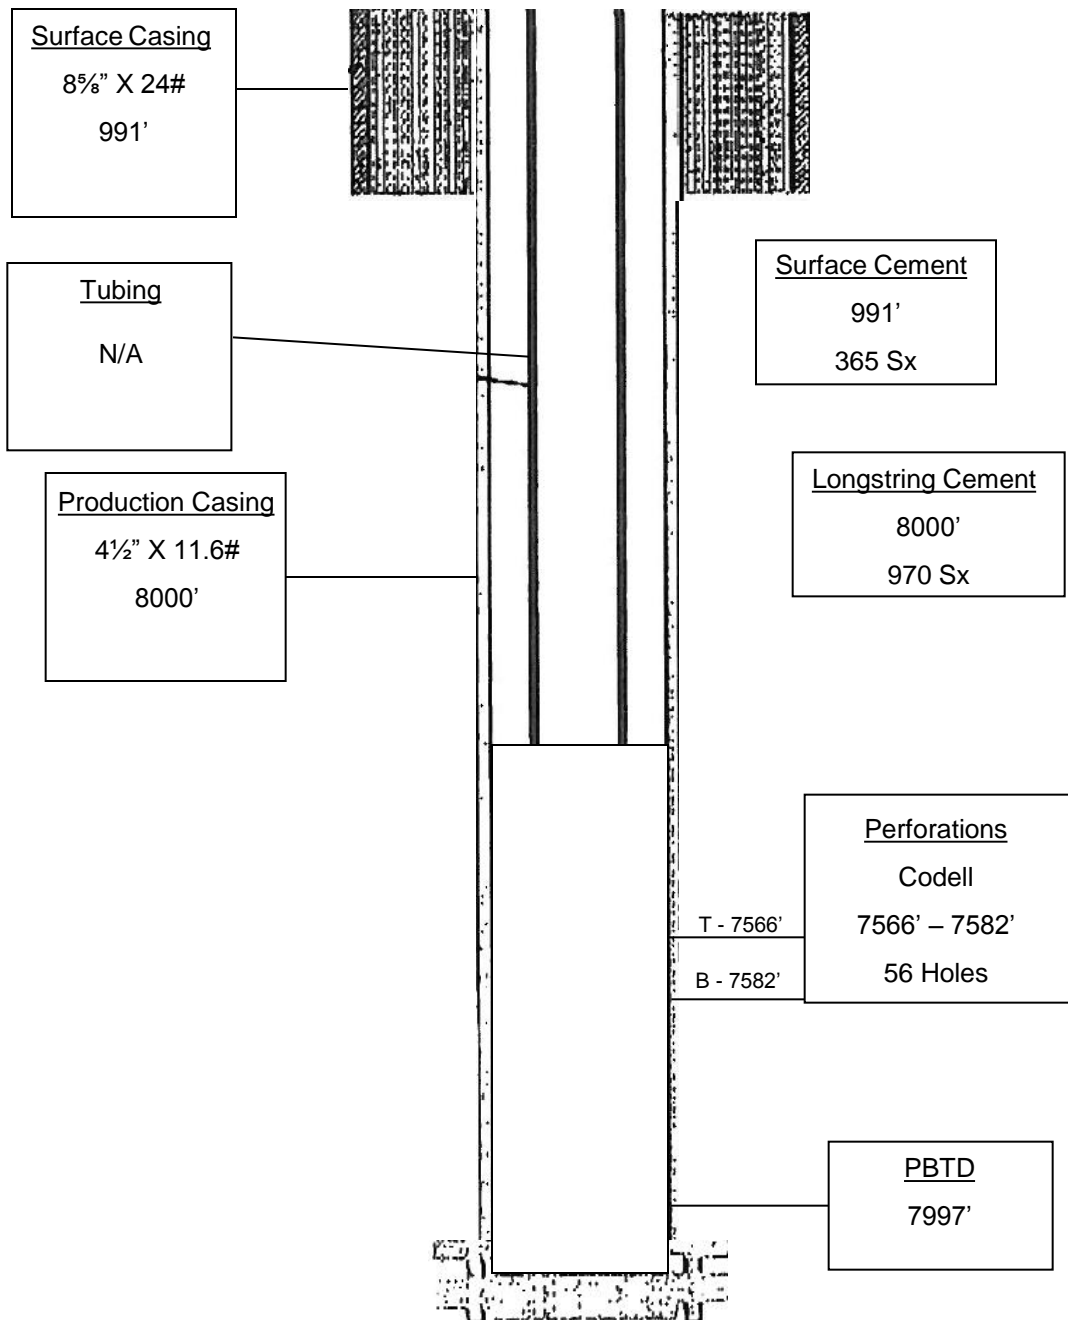

**Wellbore Diagram**