


# Front Range #11-17-7

General Location:  
Nesw-Sec 17-T4N-R66W, 6Th Pm  
Township/Range: 17 004-N  
NESW-SEC.17-T4N-R66W, 6TH PM  
County: Weld, State: CO  
Spud Date: 7/20/2012  
Total Depth: 7740

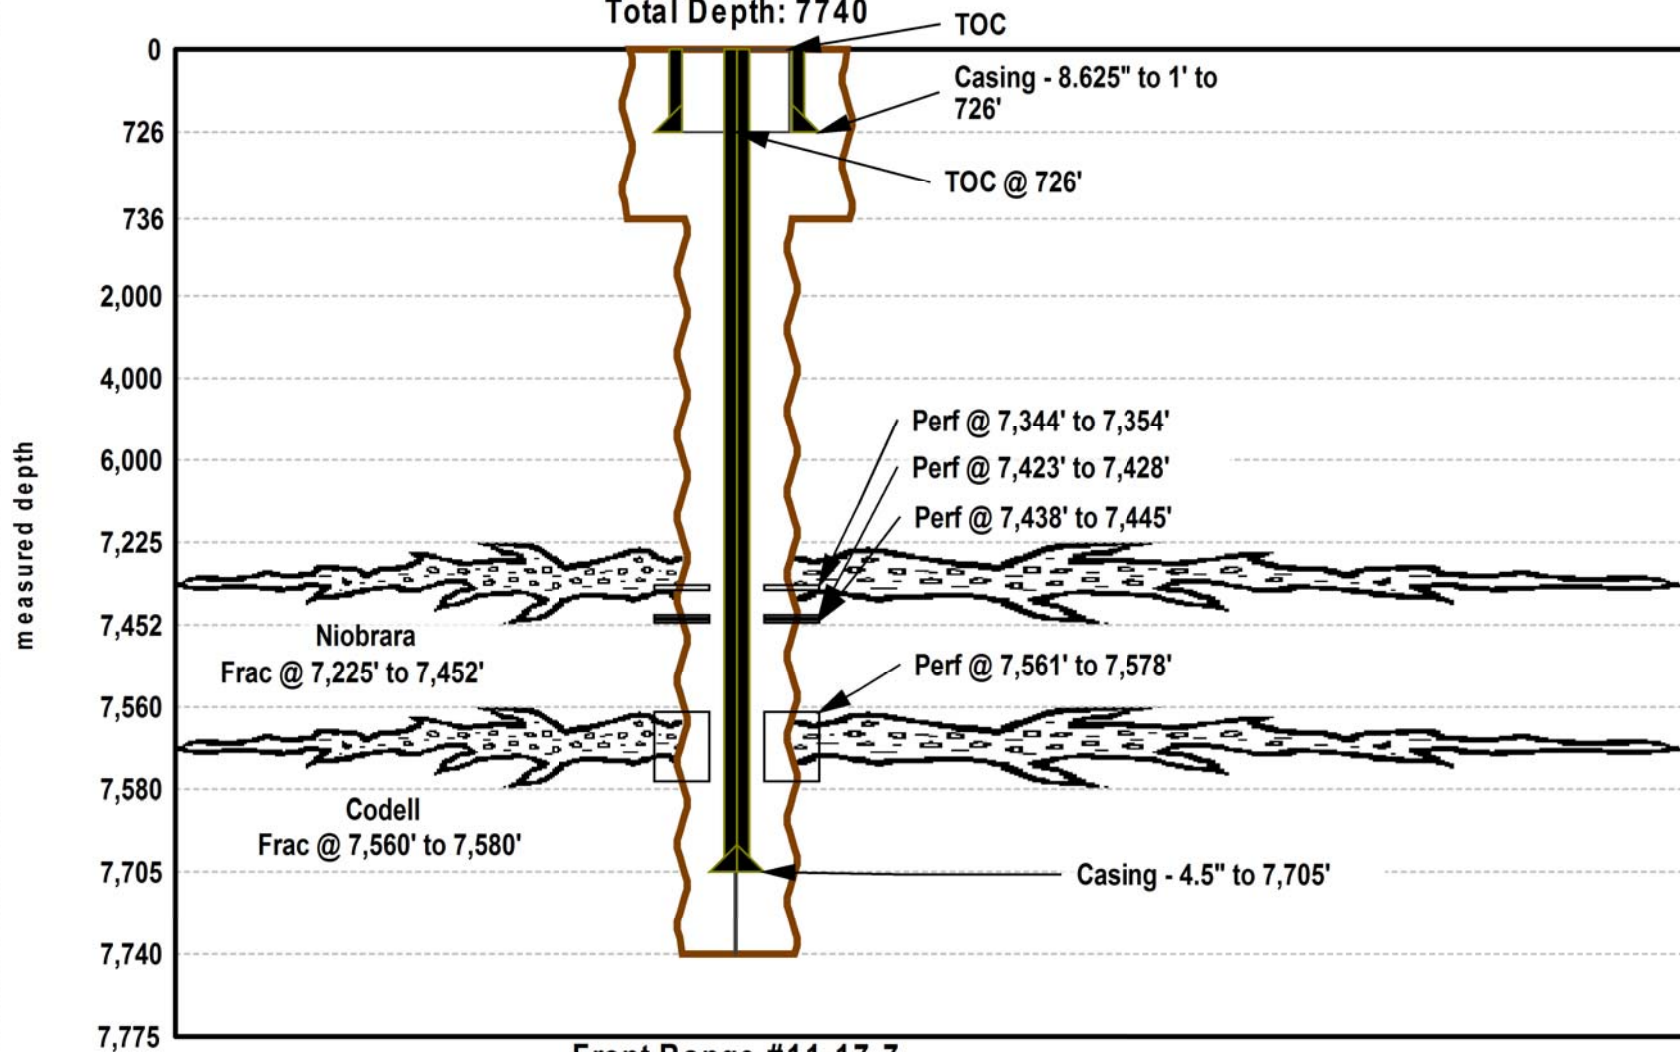

Front Range #11-17-7  
Initial Completion: 8/24/2012  
Proposed Depth: 8883 Plug Back Depth: 7681